


T. 4S., R. 24E., W.M.

MORROW COUNTY

SCALE 1" = 1320'

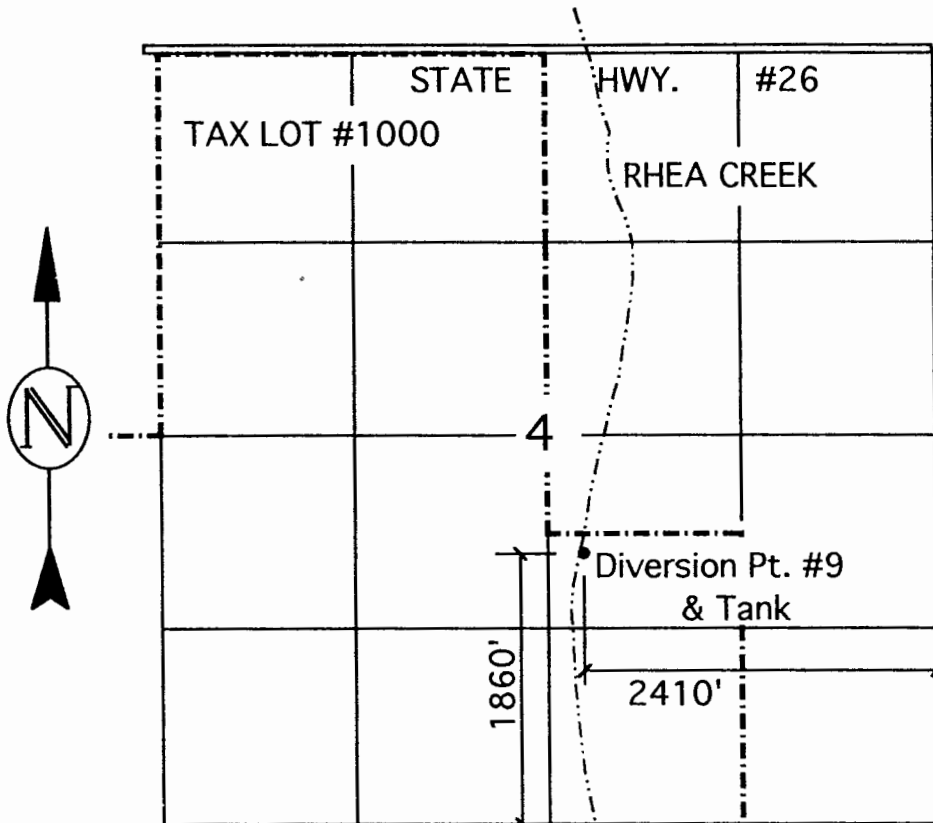

Application #S-72682
Permit #S-52586

Application # R-72677
Permit # R-11915

Diversion Pt. & Stock Tank Located in NW 1/4, SE 1/4 Section 4
1860 Ft North & 2410 Ft West of Southeast Corner Section 4

WATER RIGHTS PROOF MAP

 Water Rights Found at This Location

IN NAME OF

LEE PALMER

THIS MAP IS FOR THE PURPOSE
OF IDENTIFYING THE LOCATION
OF WATER RIGHTS ONLY AND IS
NOT INTENDED TO PROVIDE THE
LEGAL DIMENSIONS OR LOCATIONS
OF PROPERTY OWNERSHIP LINES.



RECEIVED

AUG 31 2000

WATER RESOURCES DEPT.
SALEM, OREGON

ENGINEERING - LAND SURVEYING - WATER RIGHTS
R. V. McKINNIS ENGINEERING



79980 Prindle Loop Road
Hermiston, Oregon 97838
(541) -567-2017

