

RECEIVED

FINAL PROOF SURVEY MAP
IN THE NAME OF DARYL ROBISON


JUN 12 1986
WATER RESOURCES DEPT.
SALEM, OREGON

SECTION 33, T 31 S, R 15 W, W.M.

APPLICATION 69983
APPLICATION R-69982

PERMIT 51053
PERMIT R-11243


1 INCH = 1320 FEET

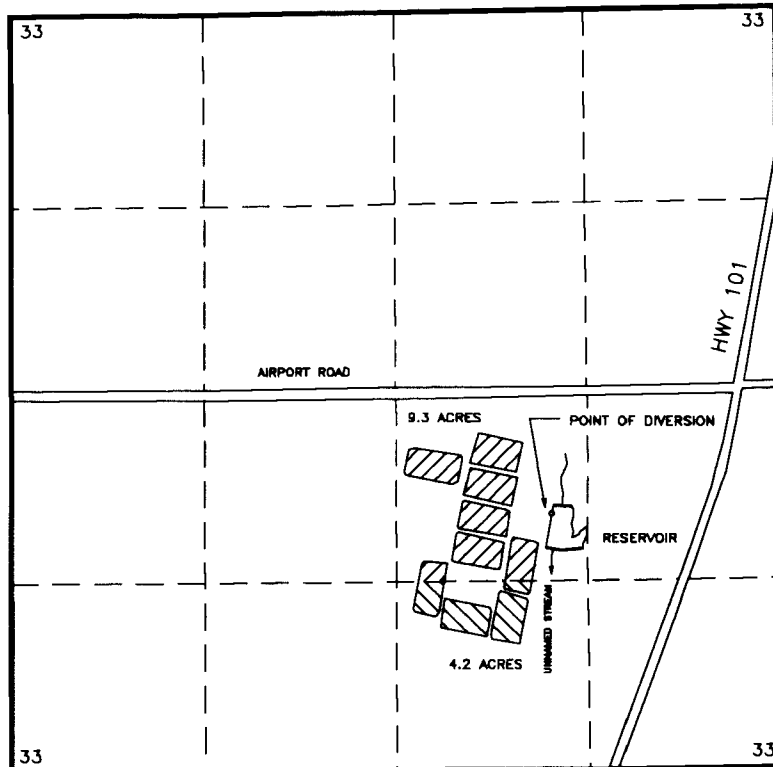

THE POINT OF DIVERSION IS LOCATED 1,750 FEET NORTH AND 1,575 FEET WEST FROM THE SOUTHEAST CORNER OF SECTION 33, BEING WITHIN THE NW¹/₄ OF THE SE¹/₄ OF SECTION 33, TOWNSHIP 31 SOUTH, RANGE 15 WEST, W.M., CURRY COUNTY.

THE PURPOSE OF THIS MAP IS TO IDENTIFY THE LOCATION OF THE WATER RIGHT.
IT IS NOT INTENDED TO PROVIDE INFORMATION RELATIVE TO THE LOCATION OF
PROPERTY OWNERSHIP BOUNDARY LINES.

Certified Water Right Examiner
#054 WRE
James F. Gosson
James F. Gosson
Nov. 19, 1987
STATE OF OREGON