

RECEIVED

FINAL PROOF SURVEY MAP
IN THE NAME OF DARYL ROBISON


JUN 12 1986

WATER RESOURCES DEPT
SALEM, OREGON

SECTION 33, T 31 S, R 15 W, W.M.

APPLICATION 69983
APPLICATION R-69982

PERMIT 51053
PERMIT R-11243

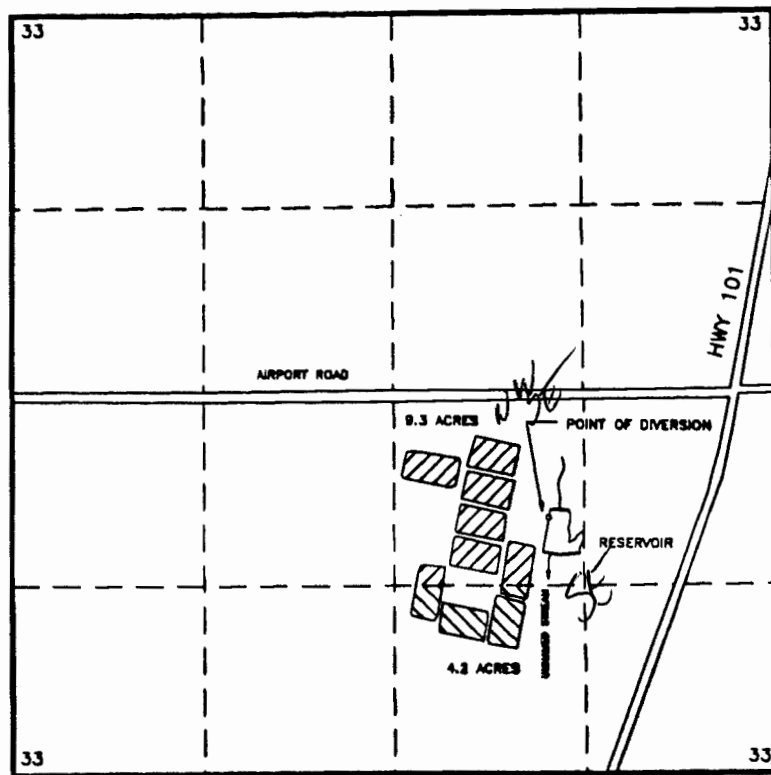

THE POINT OF DIVERSION IS LOCATED 1,750 FEET NORTH AND 1,575 FEET WEST FROM THE SOUTHEAST CORNER OF SECTION 33, BEING WITHIN THE NW¼ OF THE SE¼ OF SECTION 33, TOWNSHIP 31 SOUTH, RANGE 15 WEST, W.M., CURRY COUNTY.

THE PURPOSE OF THIS MAP IS TO IDENTIFY THE LOCATION OF THE WATER RIGHT.
IT IS NOT INTENDED TO PROVIDE INFORMATION RELATIVE TO THE LOCATION OF
PROPERTY OWNERSHIP BOUNDARY LINES.

