
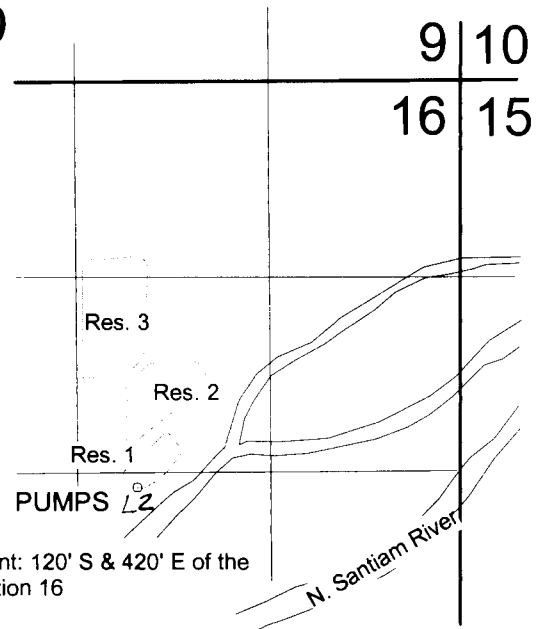


FINAL PROOF SURVEY MAP



T 9 S, R 1 W, W.M.
Portions of sections 16, 20, and 29

Prepared for NORPAC FOODS, INC.

Application 80504 Permit 52058

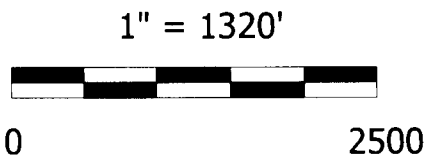

Diversion Point: 120' S & 420' E of the center of section 16

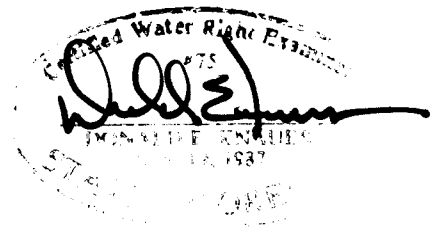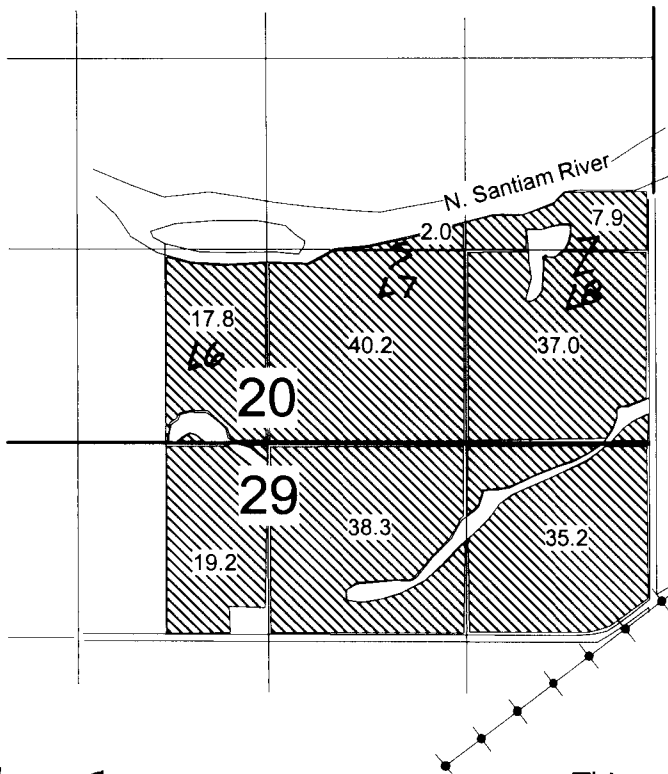

*Glots added to map WRD
12/30/14*

This map is for water right purposes only.