


**Township 39 South, Range 1 East
Section 6, W.M.**

NE 1/4 NE 1/4



Jackson County

Application # G-15102

Permit # G-14980

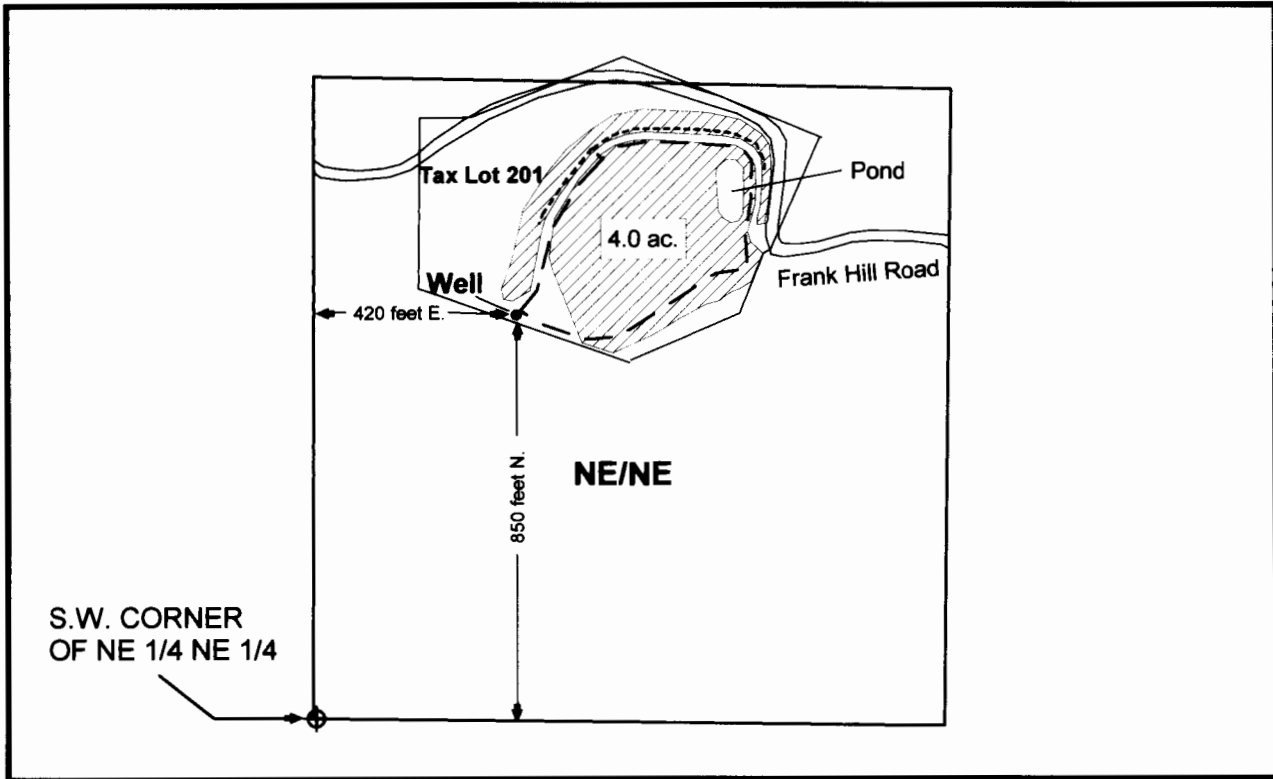


Legend

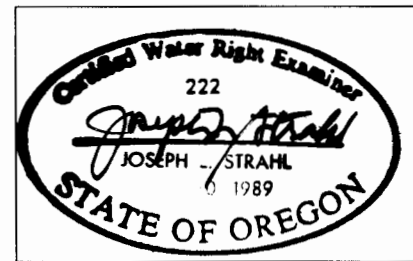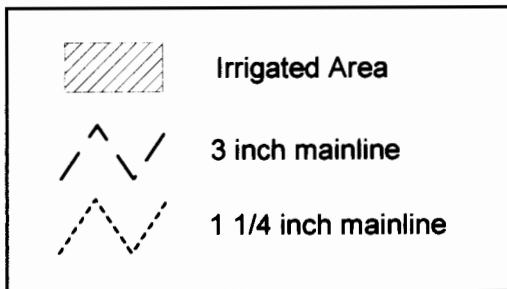

Scale 1 inch = 400 feet

This map is not intended to provide legal dimensions or locations of property lines

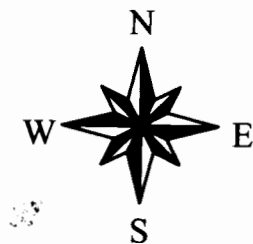

Claim of Beneficial Use

For
Victor and Eileen Chieco

July 23, 2006

n.e.d.

