


T.4 N., R.34-35 E., W.M.

AREA OF USE

URBAN GROWTH BOUNDARY

CITY LIMITS

1" = 800'

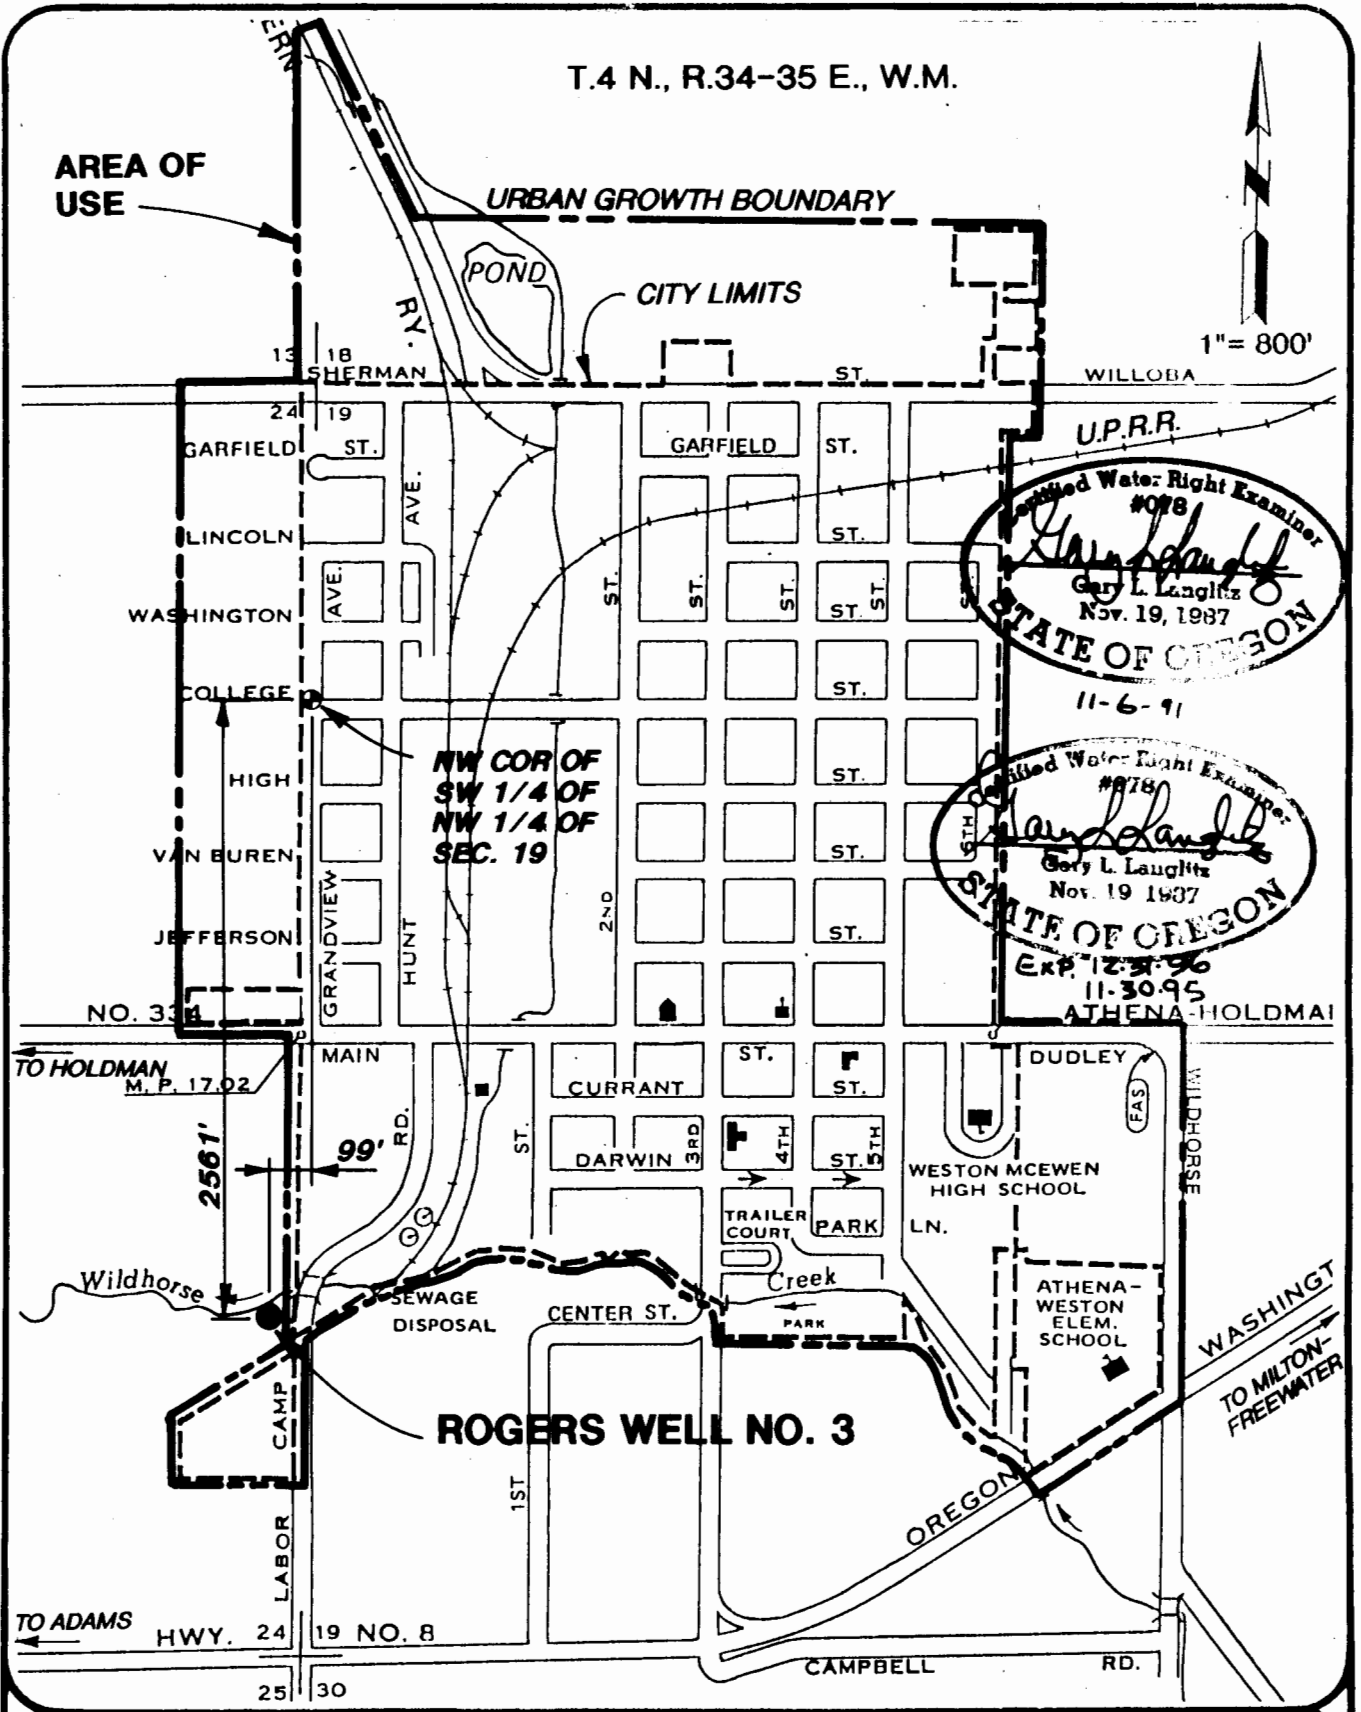

 #078
Gary L. Laughtz
 Gary L. Laughtz
 Nov. 19, 1987
 STATE OF OREGON
 11-6-91

 #078
Gary L. Laughtz
 Gary L. Laughtz
 Nov. 19, 1987
 STATE OF OREGON
 EXP. 12-31-96
 11-30-95
 ATHENA-HOLDMAI

ROGERS WELL NO. 3

anderson
derry
 associates, inc.

CITY OF
 ATHENA, OREGON
 FINAL PROOF SURVEY MAP
 ROGERS WELL NO. 3

FIGURE