


T. 15S., R. 10E., W.M.

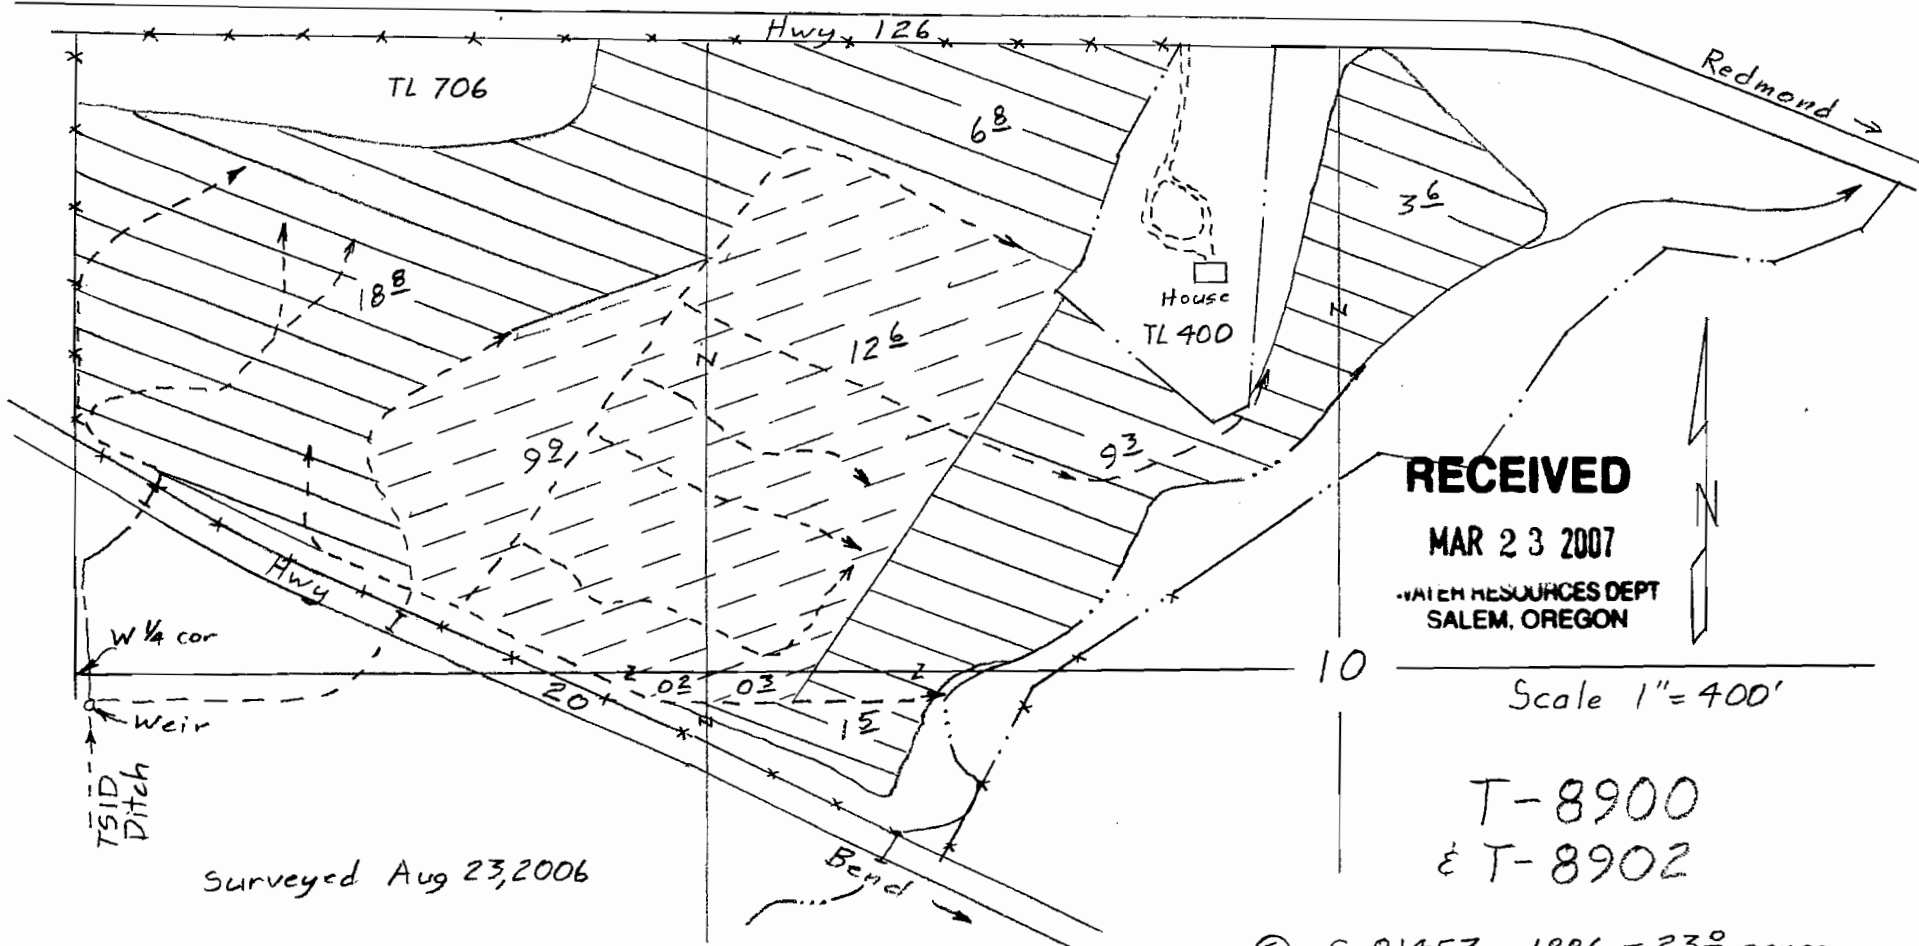


Surveyed Aug 23, 2006

Claim of Beneficial Use Map
for


- ⊖ C-81453 1886 - 23⁰⁰ acres
- ⊖ C-863 1895 - 40⁰⁰ acres

T. 15S., R. 10E., W.M. Hawks Haven Reserve, LLC

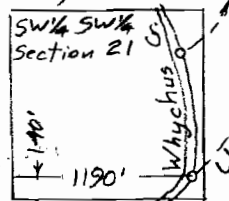

Scale 1" = 1320'

This map is for the purpose of locating a water right only and has no intent to provide legal dimensions or the location of property lines.

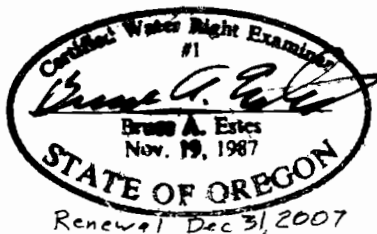

ESTES SURVEYS, LLC

PO Box 17519 Salem, OR 97306-7519 (503) 585-7593	60382 Arnold Rd Bend, OR 97702 (541) 382-7391
--	---