


T.15S., R.10E., W.M.

RECEIVED

MAR 23 2007

WATER RESOURCES DIVISION  
SALEM, OREGON

Claim of  
Beneficial Use Map  
for  
Armestoy Ranch

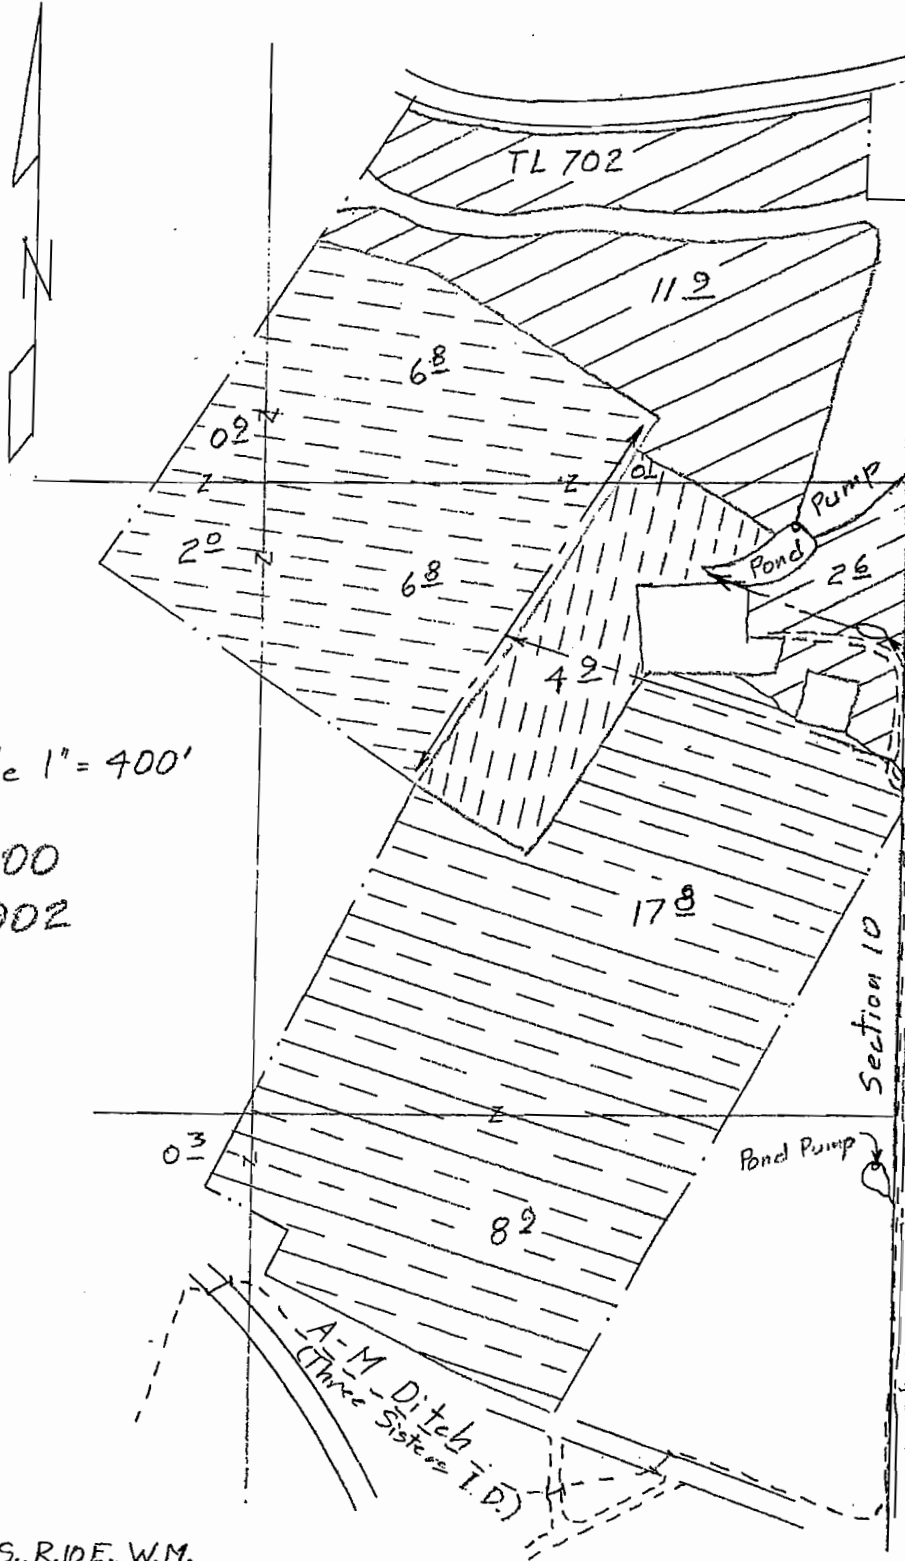

E 1/4 corner of section 10

- ⊖ C-81454 1900 16 1/2 ac.
- ⊖ C-57115 supp. 16 1/2 ac.
- ⊖ C-74135 1903 5 1/2 ac.
- ⊖ C-982 1908 27 1/2 ac.
- ⊖ C-2056 1912 14 1/2 ac.


Scale 1" = 400'

T-8900  
& T-8902

Surveyed Aug 23 &  
Dec 29, 2006


This map is for the purpose of  
locating a water right only  
and has no intent to provide  
legal dimensions or the location  
of property lines.

T.15S., R.10E., W.M.

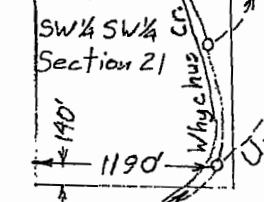


Scale 1" = 1320'

T.15S., R.10E., W.M.

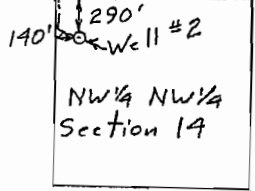

Scale 1" = 1320'

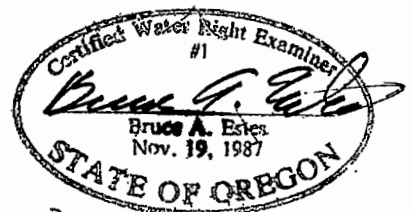

Renewal Dec. 31, 2007

**ESTES SURVEYS, LLC**

PO Box 17519  
Salem, OR 97306-7519  
(503) 585-7593

60382 Arnold Rd  
Bend, OR 97702  
(541) 382-7391