


T. 8S., R. 42E., W.M.

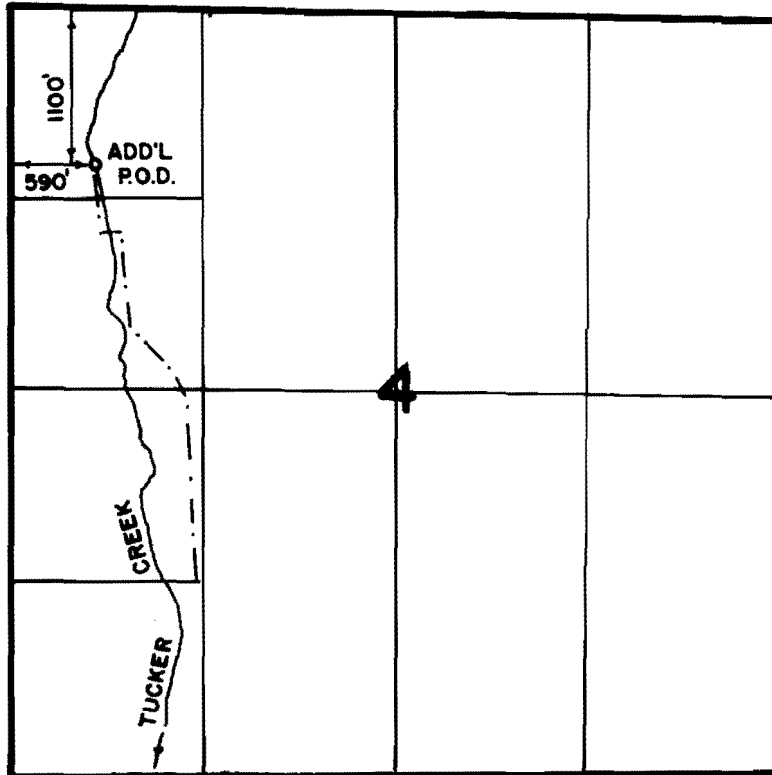

Scale 1" = 1320'

THE PURPOSE OF THIS MAP IS FOR IDENTIFYING THE LOCATION OF THE WATER RIGHT ONLY AND IS NOT INTENDED TO PROVIDE LEGAL DIMENSIONS OF PROPERTY OWNERSHIP LINES.

## FINAL PROOF SURVEY


TRANSFER 6934

IN NAME OF

Robert & Virginia Lowry

Surveyed

Sept. 16, 1998

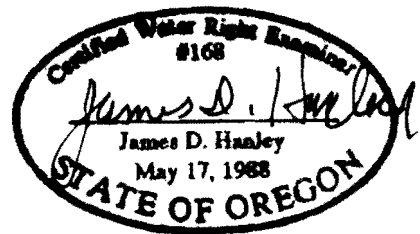

**RECEIVED**

SEP 29 1998

WATER RESOURCES DEPT.  
SALEM, OREGON