


0 660 1,320 2,640 3,960 5,280 Feet

1" = 1320'



HARNEY COUNTY, OREGON

**T 20 S, R 36 E, WM
SECTIONS 3 & 4**

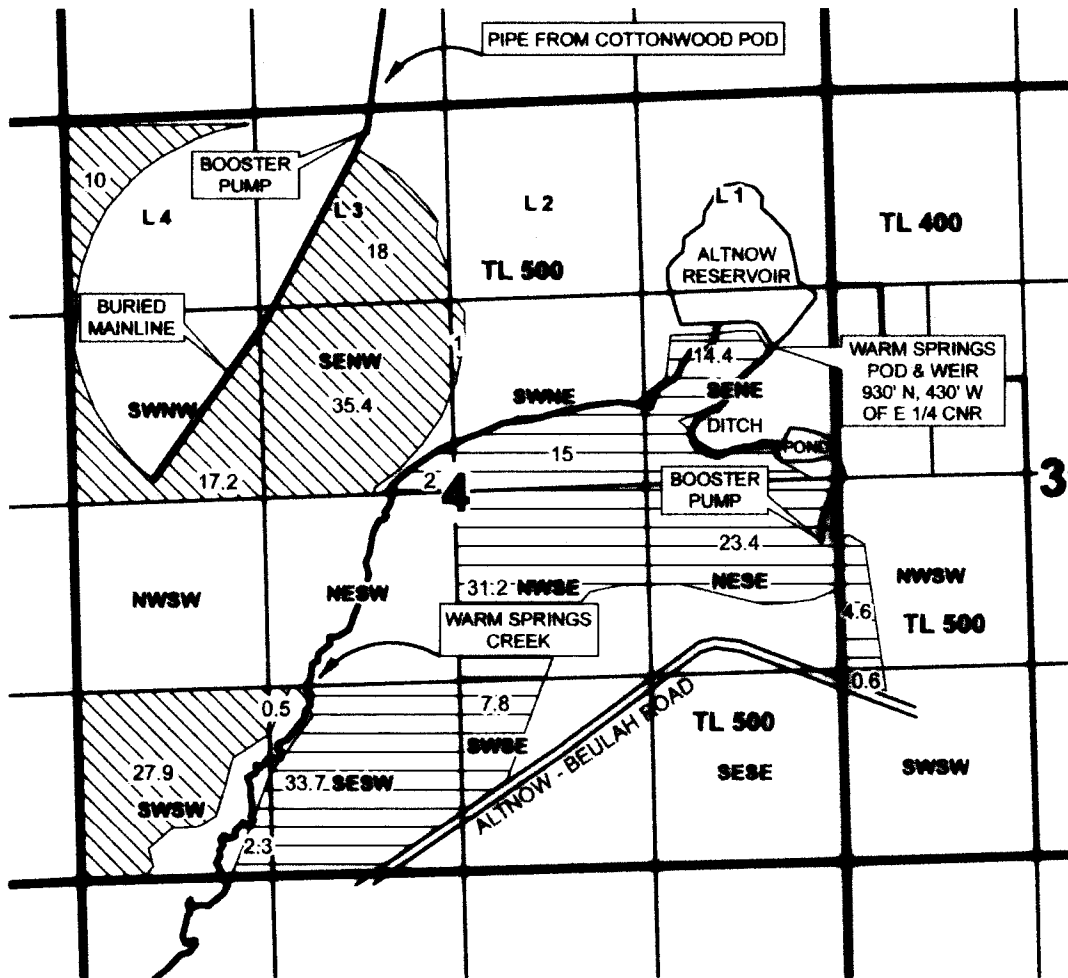

- TAX LOT LINES
- 7/5/1883 WARM SPRINGS CREEK PRIMARY
- 3/13/1885 COTTONWOOD CREEK PRIMARY



RENEWAL DATE: 12/31/2015



**CLAIM OF BENEFICIAL USE MAP
FOR COTTONWOOD CREEK RANCH**

TRANSFER T-11676

NOTE: THIS MAP IS NOT INTENDED TO
PROVIDE LEGAL DIMENSIONS OR LOCATIONS
OF PROPERTY OWNERSHIP LINES.

JOB # 14055

AUGUST 28, 2014

WATER RIGHT SERVICES, LLC
PO BOX 1830, BEND, OR 97709

CCB # 197121 WWW.OREGONWATER.US

541-389-2837 JOHNSHORT@USA.COM