


Appl. # 11395
Per. # 7880

MAP
of
Bays and Woods Water Right

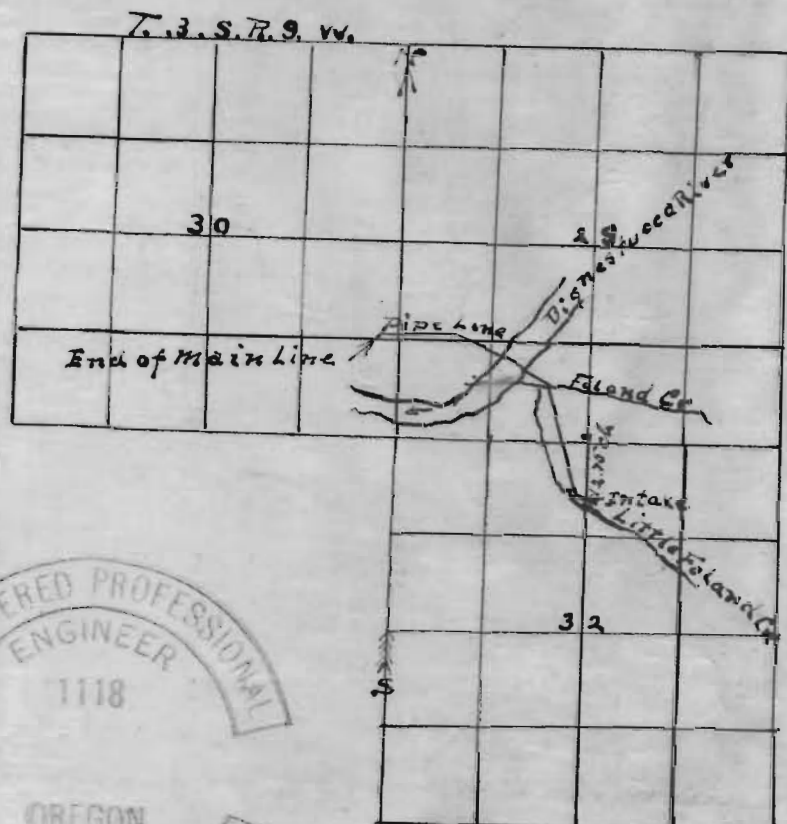

Field Notes

Beginning 12.75 chains south and 1.86 chains west of the N.E. corner of the N.E. 1/4 of the N.W. 1/4 of Section 32, T. 3. S. R. 9. W. W.M.

Thence N. 64° W. 27.5 chains
" N. 16° W. 23.90 chains
" N. 61° W. 7.00 "
" N. 64° 20' W. 4.90 "
" N. 71° 45' W. 9.00 "
" S. 89° 15' W. 15.00 - End of Main Line



CERTIFICATE OF SURVEYOR

I, A. M. AUSTIN, of TILLAMOOK COUNTY, OREGON, do hereby certify that this map was made from notes taken during an actual survey made by me (or under my immediate supervision) on April 17th 1927, and that it correctly represents the works described in the accompanying application, together with the location of streams and other ditches in the immediate vicinity, and has written thereon the area in each smallest legal subdivision which it is proposed to irrigate.

A. M. Austin
Surveyor -

Application No. 11395
Permit No. 7880