


RECEIVED

SEP 16 1999

LAND RESOURCES DEPT.
SAI FM OREGON

T.4S. R.2 & 3W., W.M

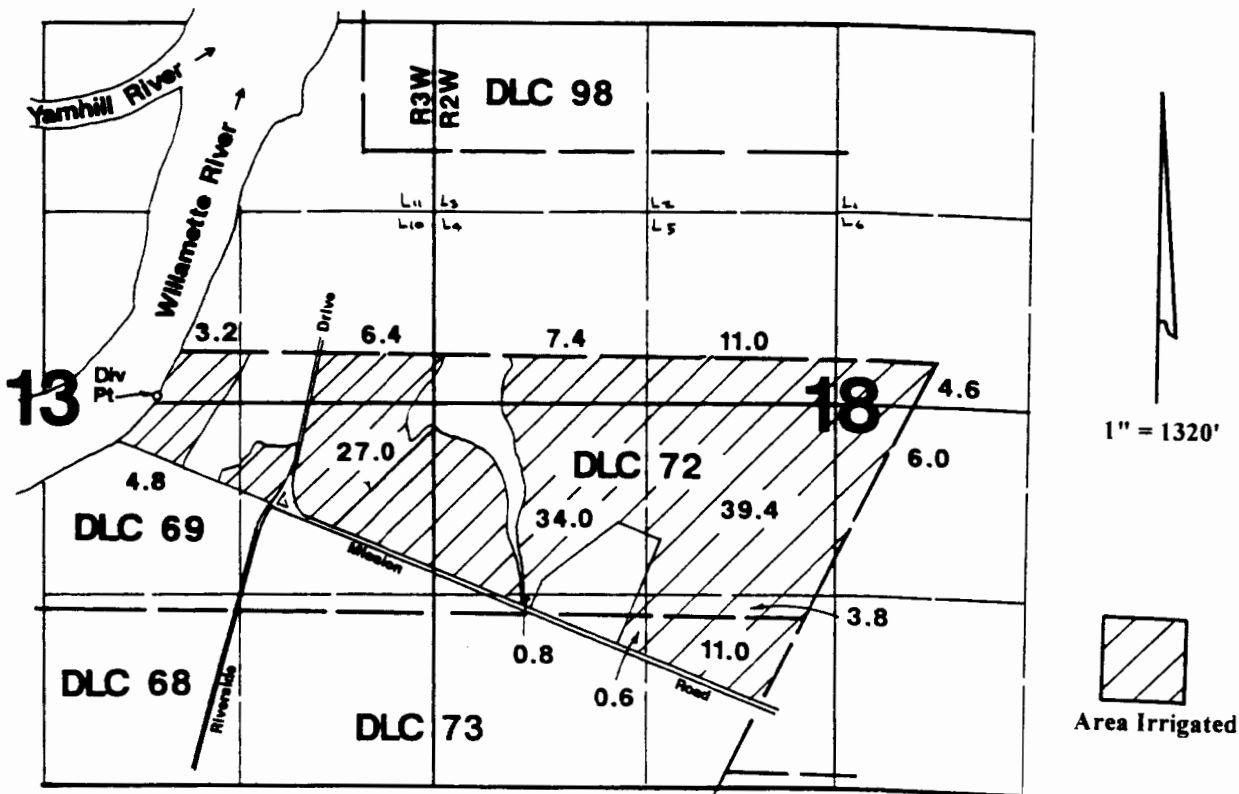

POD is located 40°N & 800'E from the center of Section 13..

Final Proof Survey

Application #: S-75735 Permit #: 51716

In Name Of

Mission Lane Farms

Surveyed on September 3, 1999 by JM Schuette

This Map Was Prepared For The Purpose Of Identifying The Location Of A Water Right Only And Is Not Intended To Provide Legal Dimensions Or Location Of Property Ownership Lines.

