T 24 S, R 34 E, WM

RECEIVED
FEB 09 2007
WATER RESOURCE DEPT.
EASTERN REGION

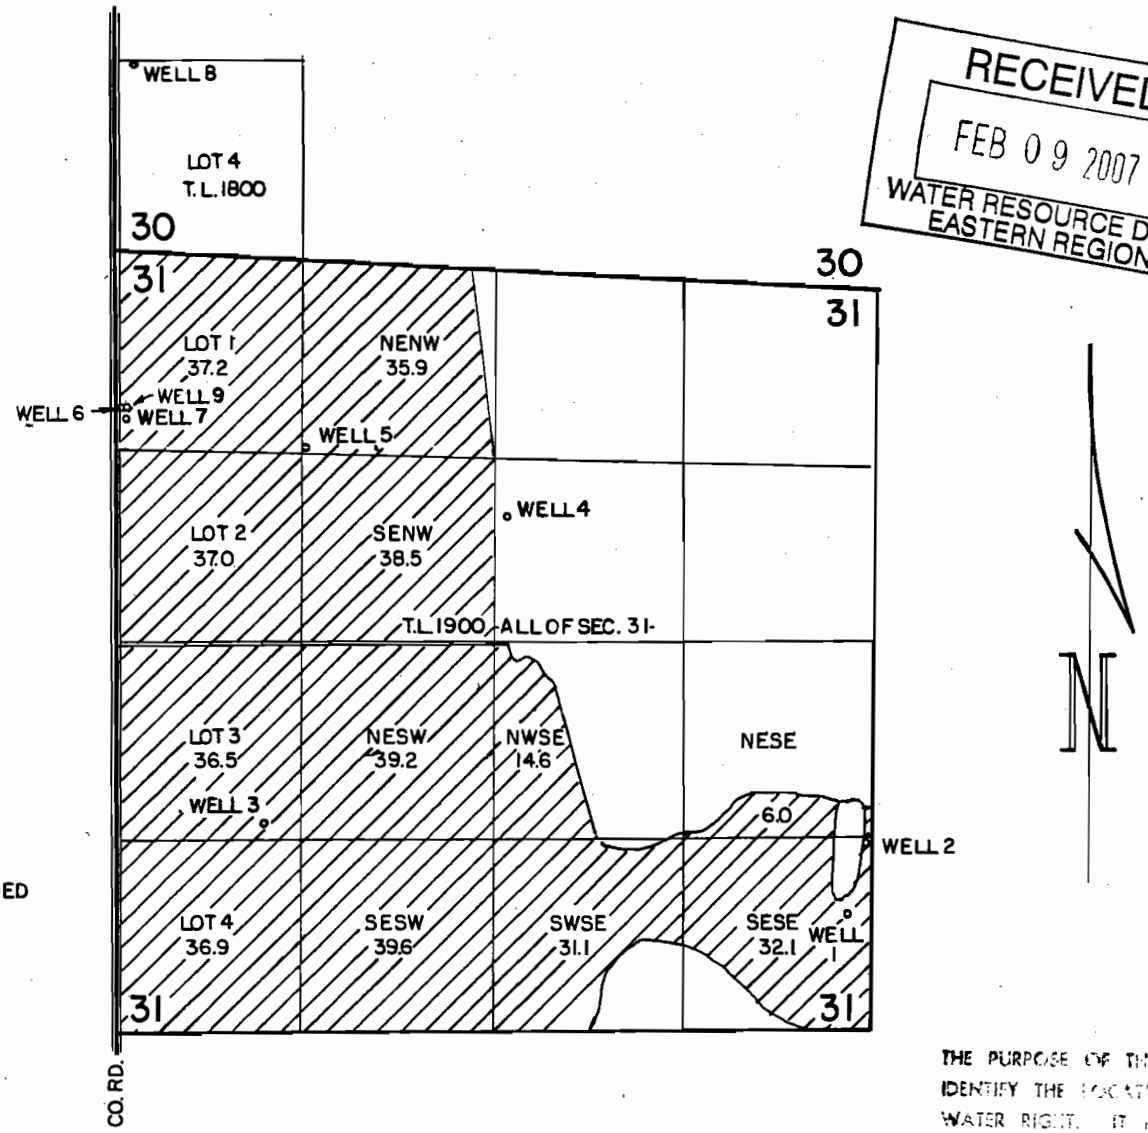

01-11-2007 ADDED WELL 6 & 9.

THE PURPOSE OF THIS MAP IS TO IDENTIFY THE LOCATION OF THE WATER RIGHT. IT IS NOT INTENDED TO PROVIDE INFORMATION RELATIVE TO THE LOCATION OF PROPERTY OWNERSHIP.

WELL 1 - 780'N 170'W FROM S.E. COR. OF SEC. 31.
WELL 2 - 1260'N 60'W " " " " " "
WELL 3 - 1410'N 1020'E " S.W. " " " "
WELL 4 - 3480'N 2660'E " " " " " "
WELL 5 - 3950'N 1320'E " " " " " "

CERT. 36878

WELL 6 - 980'S 50'E FROM N.W. COR. OF SEC. 31.
WELL 7 - 1100'S 90'E FROM N.W. COR. OF SEC. 31.
WELL 8 - 1310'N 153'E " S.W. " " " 30.
WELL 9 - 970'S 90'E FROM N.W. COR. OF SEC. 31.

ADDITIONAL POINTS OF APPROPRIATIONS

JERRY RANK

WATER RIGHT TRANFER APPLICATION

REGISTERED PROFESSIONAL ENGINEER
6100
Gordon T. Palmer
Exp. 12-31-2007
STATE OF OREGON

RENEW 1-1-2007

Scale: 4" = 1 MILE	Date: MARCH 2006	Job: 2313
Dsn:	MAP's M.A. PALMER & SONS, INC. ENGINEERING & SURVEYING 711 Ponderosa Village • Box 61 Burns, Oregon 97720	Sht. No.
Drn: CHRIS		of 1
Ckd:		