


CLAIM OF BENEFICIAL USE MAP

APPLICATION S-86647 PERMIT S-54428
IRRIGATION AND SUPPLEMENTAL IRRIGATION
FOR


TRENT NISTLER
121 GENESSEE STREET
MEDFORD, OREGON 97504
SITUATED IN

SECTIONS 29, TOWNSHIP 35 SOUTH, RANGE 2 WEST, W.M.
JACKSON COUNTY, OREGON

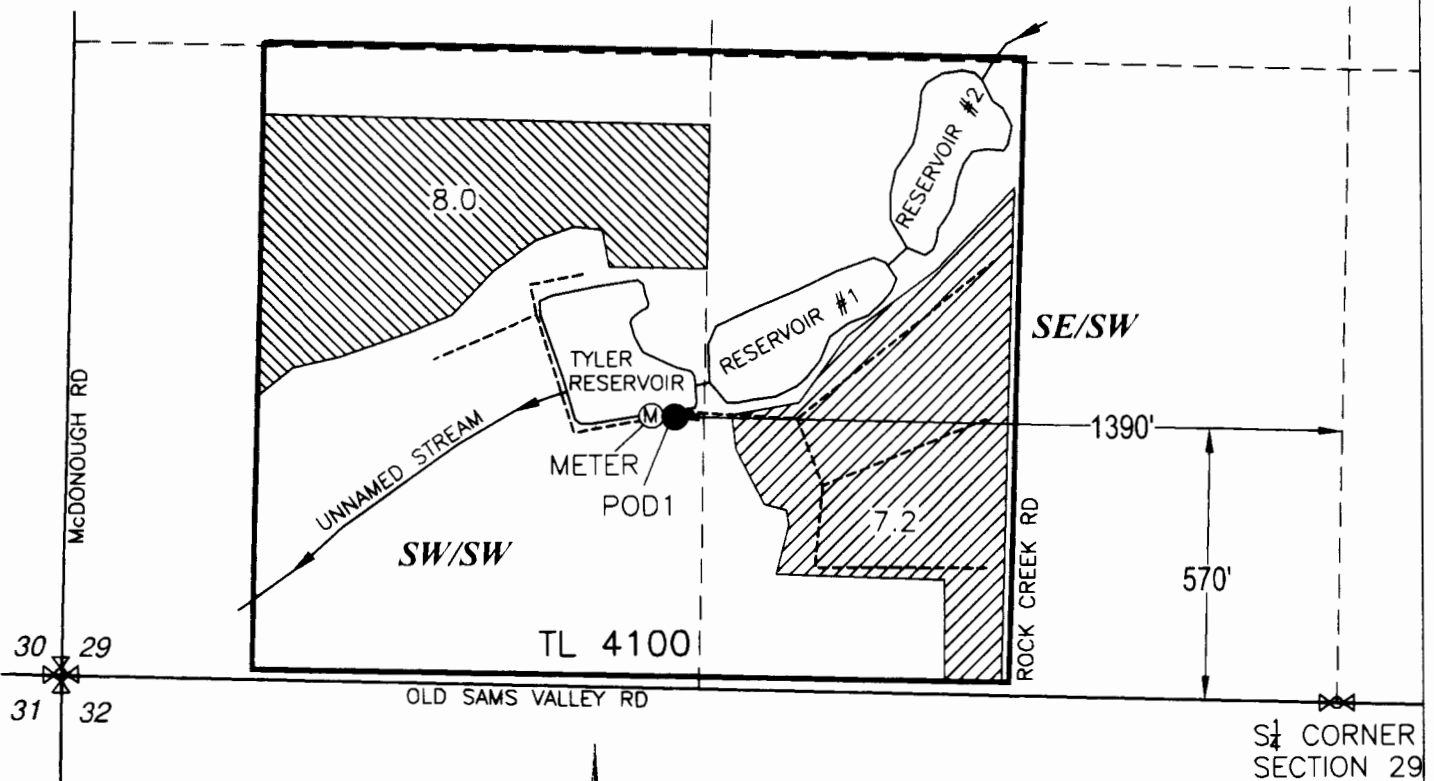

This map is not intended to
provide legal dimensions or
locations of property
ownership lines.

EHM-July 10, 2014
RH2 ENGINEERING, INC.
www.rh2.com 1.800.720.8052

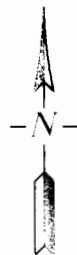

0 200 400
SCALE: 1"=400'

LEGEND

● POINT OF DIVERSION (POD1) & PUMP
1390' WEST AND 570' NORTH OF
S 1/4 CORNER SECTION 29

Ⓜ FLOW METER

--- 1/4-1/4 SECTION LINE

--- WATERLINE (BURIED)

▨ PRIMARY IRRIGATION

▨ SUPPLEMENTAL IRRIGATION



RENEWS: 12/31/2014