


857

Claim of Beneficial Use Map

Permit G-17039, Application G-15130
Water Right in the Name of City of Dayton

Township 4 South, Range 3 West, Section 19, as projected within DLC 48 (W.M.)

COBU map # 857

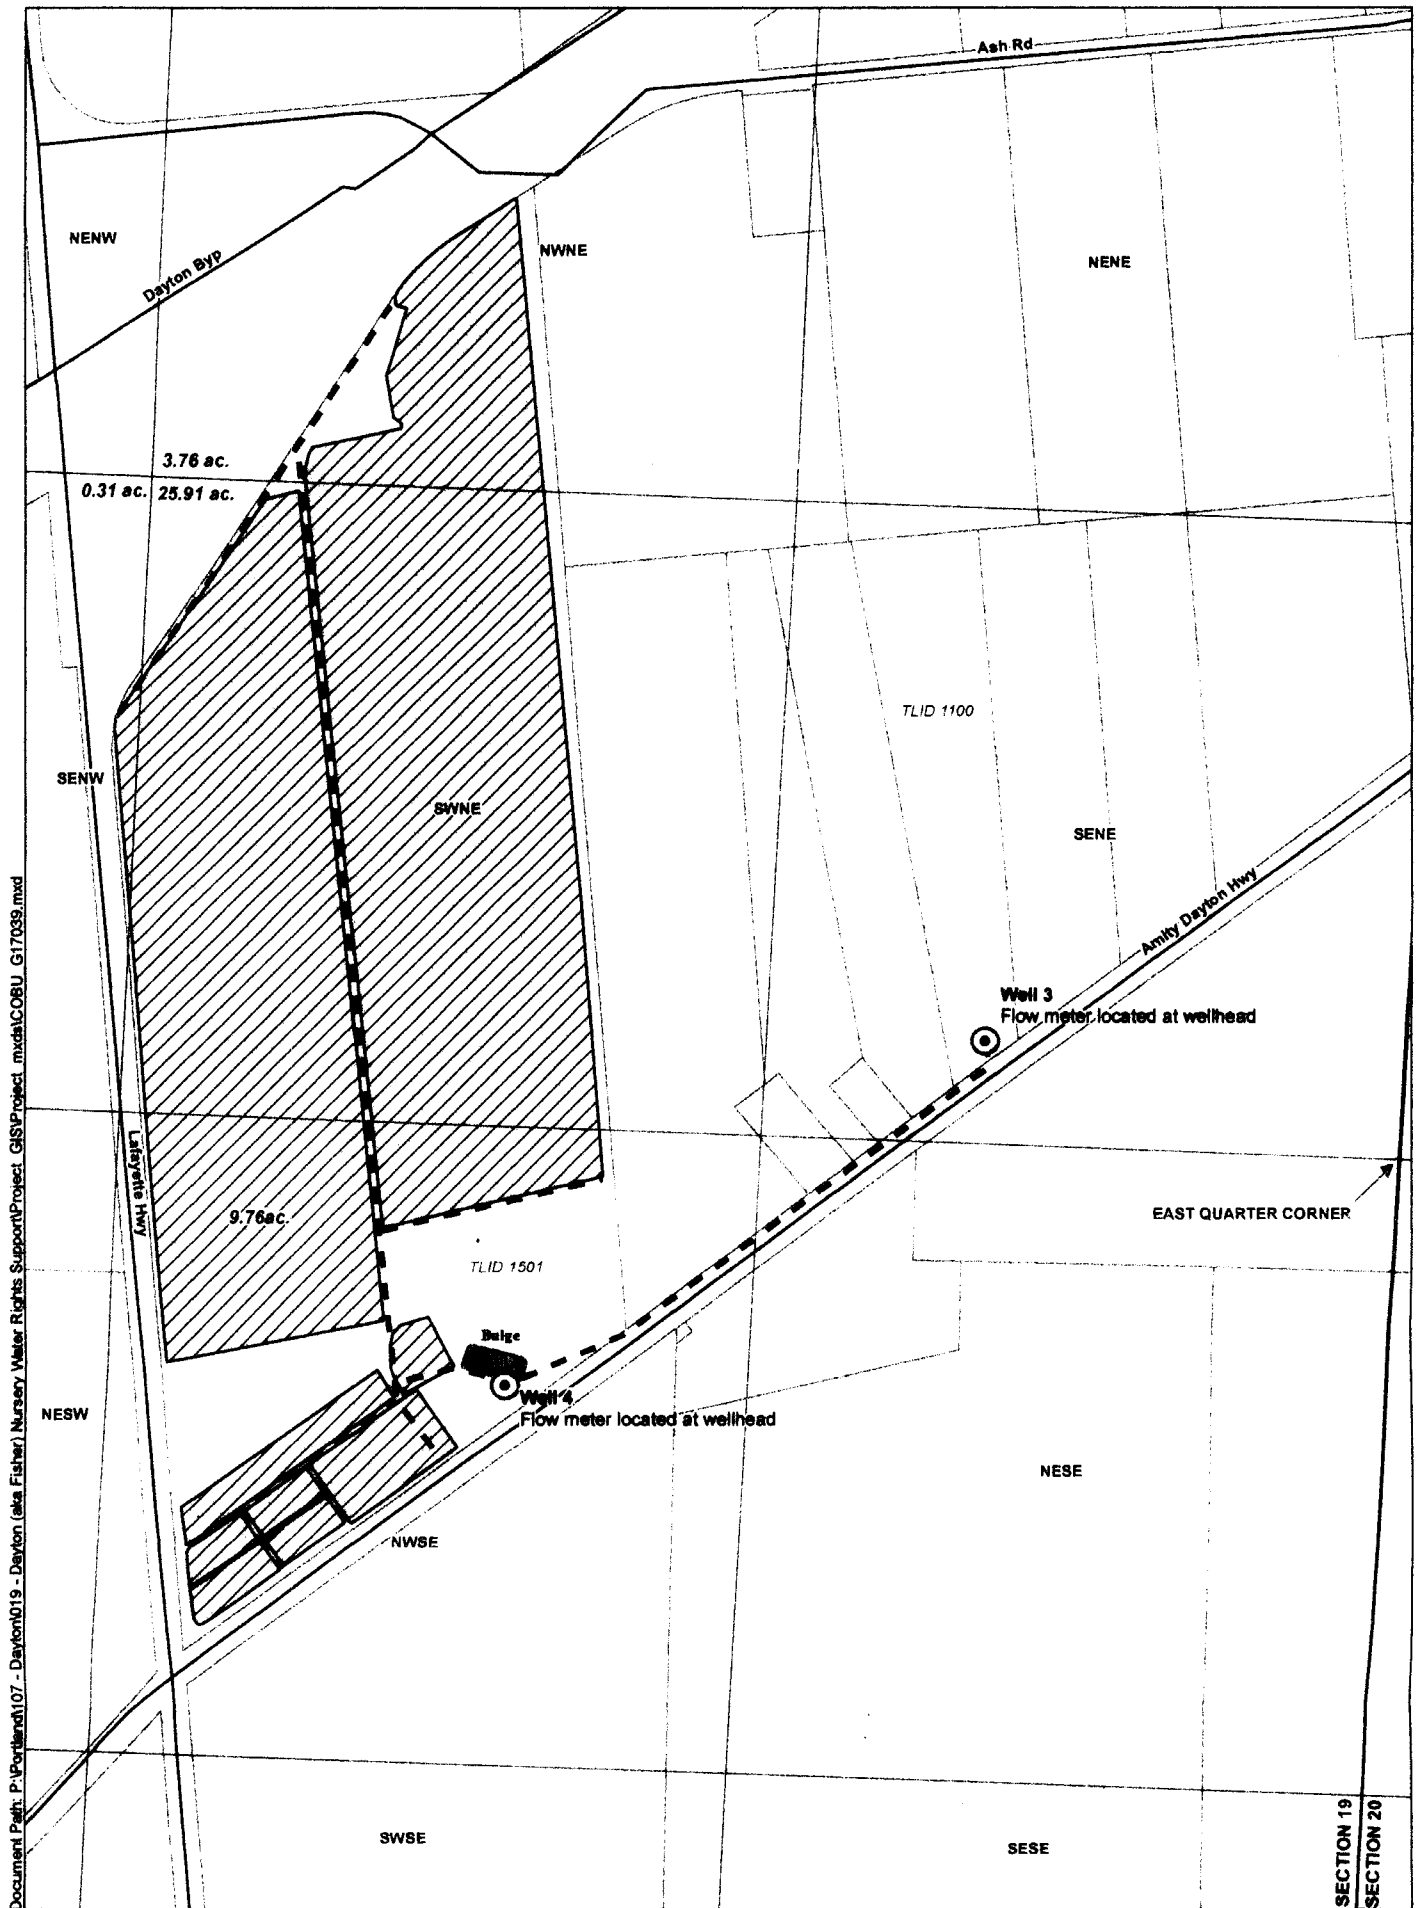


Document Path: P:\Portland\107 - Dayton\019 - Dayton (aka Fisher) Nursery Water Rights Support\Project_GIS\Project_mxd\COBU_G17039.mxd

- LEGEND**
- ⊙ Point of Appropriation (POA)
 - ▨ Place of Use (POU)
 - - - Mainline
 - Street
 - Tax Lot
 - ☪ Waterbody

POA Location Description

Well 3 (YAMH 82488)
Located 220 feet North and 880 feet West from the East quarter corner of Section 19, Township 4 South, Range 3 West (W.M.)

Well 4 (YAMH 8447)
Located 545 feet South and 1,840 feet West from the East quarter corner of Section 19, Township 4 South, Range 3 West (W.M.)

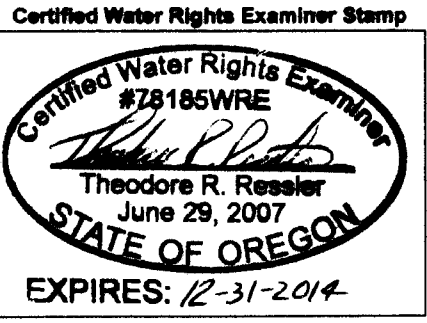

Disclaimer
This map was prepared for the purpose of identifying the location of a water right only and it is not intended to provide legal dimensions or location of property ownership lines.

Map Notes
Date: September 11, 2014
Data Sources: BLM, USGS, ESRI
Prepared By: GSI Water Solutions, Inc.

