


850

Claim of Beneficial Use Map

Permit G-15906, Application G-15445
Water Right in the Name of City of Dayton

Township 4 South, Range 3 West, Section 19, as projected within DLC 48 (W.M.)

COBU MAP # 850

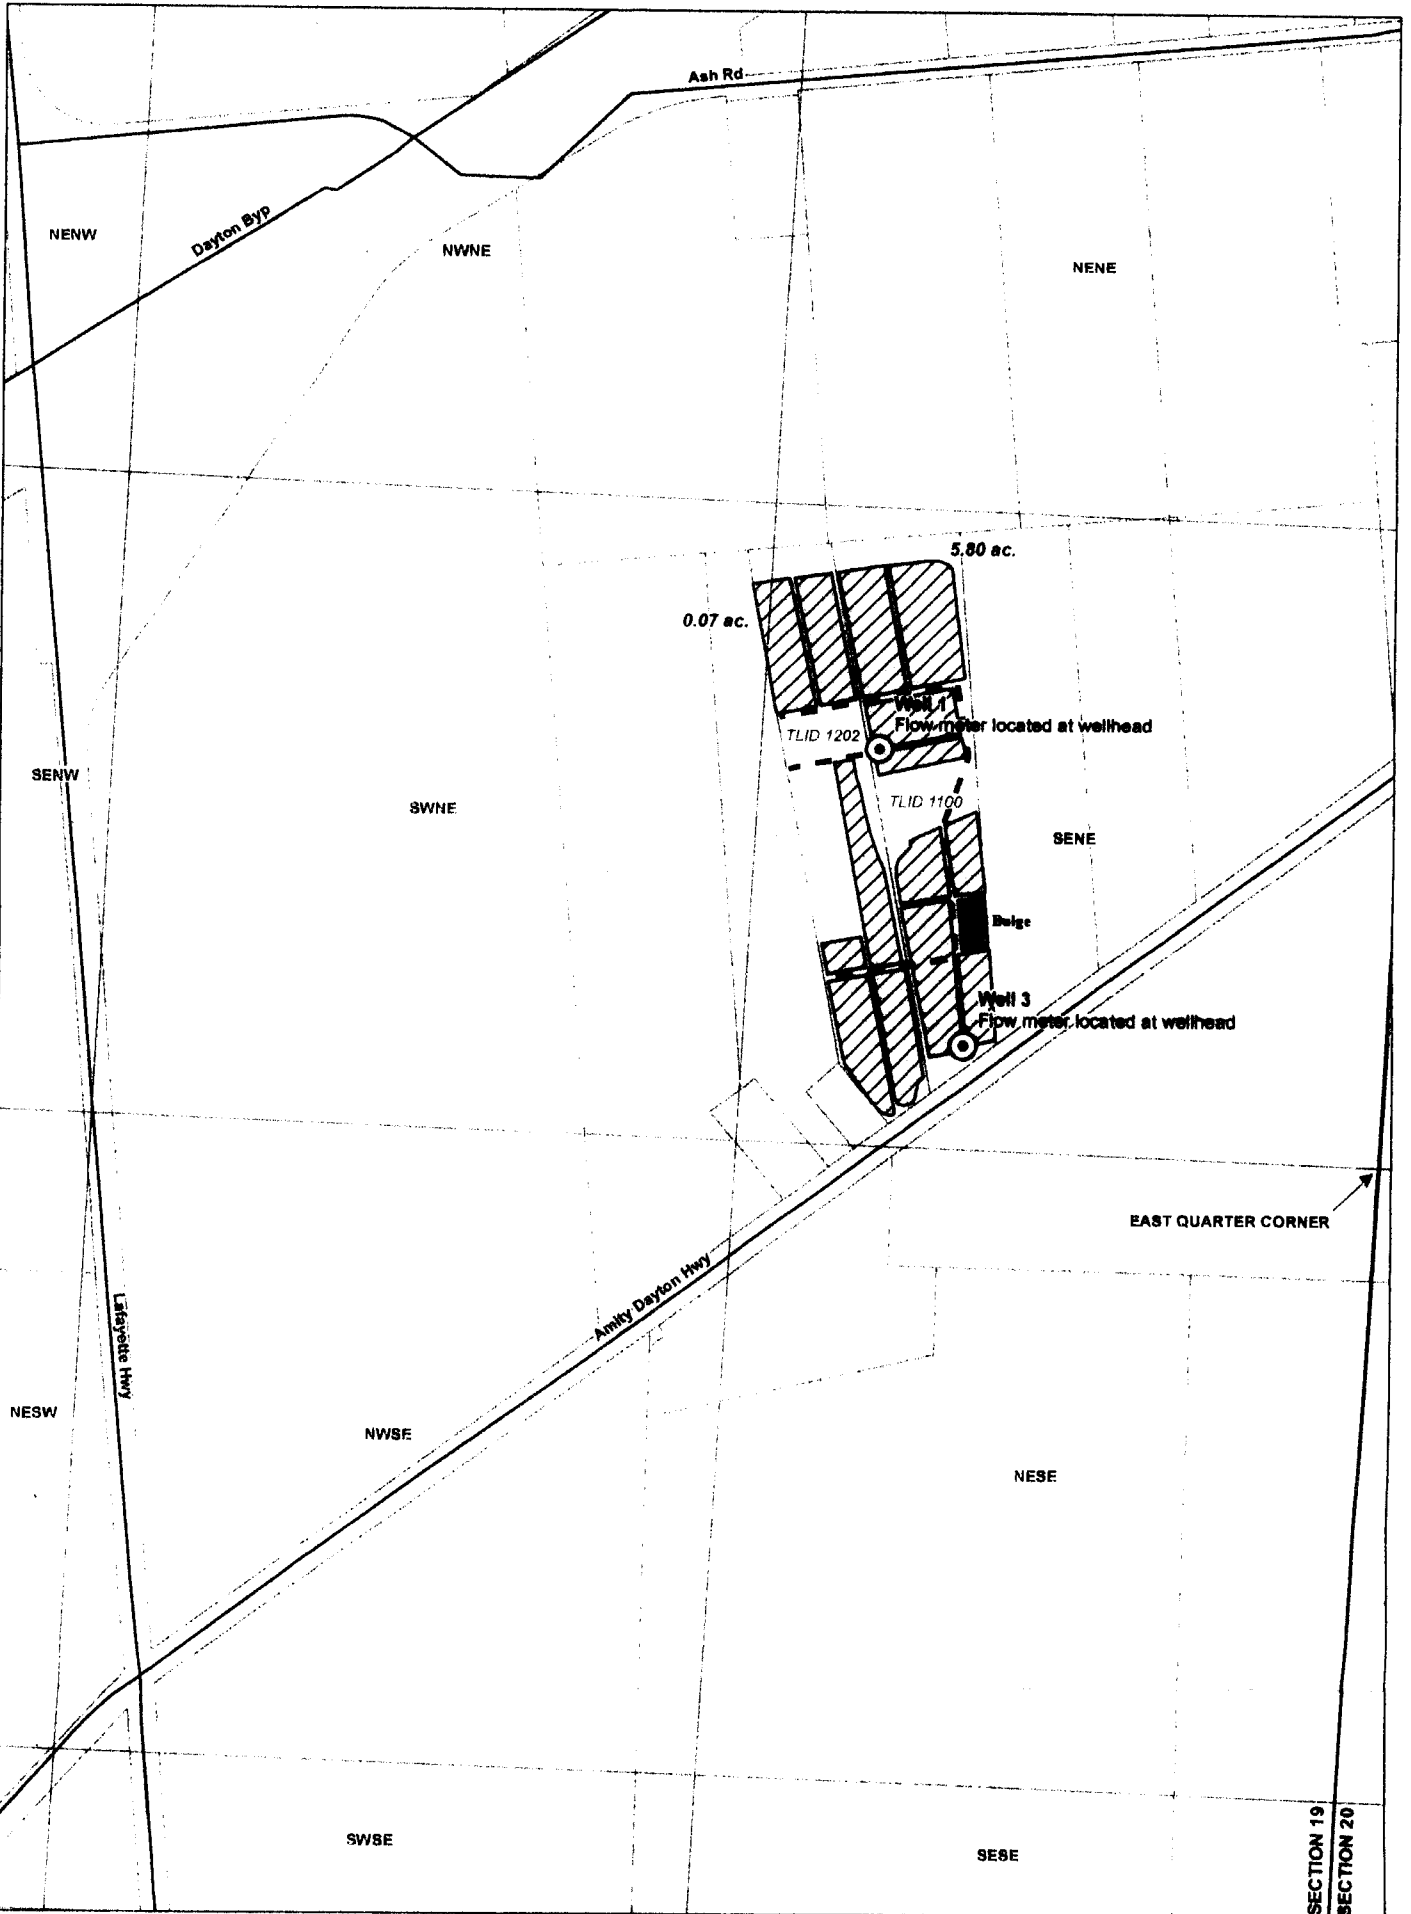

Document Path: P:\Portland\107 - Dayton (aka Fisher) Nursery Water Rights Support\Project_GIS\Protect.mxd\COBU_G15906.mxd

SECTION 19
SECTION 20

LEGEND


- Point of Appropriation (POA)
- Place of Use (POU)
- Mainline
- Street
- Tax Lot
- Waterbody

POA Location Description

Well 1 (YAMH 6370)
Located 830 feet North and 1,100 feet West from the East quarter corner of Section 19, Township 4 South, Range 3 West (W.M.)

Well 3 (YAMH 63469)
Located 220 feet North and 880 feet West from the East quarter corner of Section 19, Township 4 South, Range 3 West (W.M.)

Certified Water Rights Examiner Stamp

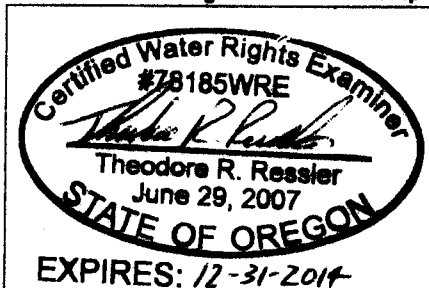

Disclaimer
This map was prepared for the purpose of identifying the location of a water right only and it is not intended to provide legal dimensions or location of property ownership lines.

Map Notes
Date: September 22, 2014
Sources: BLM, USGS, ESRI
Prepared By: GSI Water Solutions, Inc.

