

RECEIVED


OCT 02 2000

WATER RESOURCES DEPT.
SALEM, OREGON


TOWNSHIP 15 S RANGE 6 W, W.M.
Section 2

R6W T15S S2

HEWITT RD.

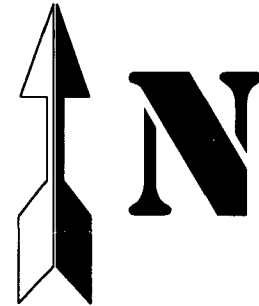

TAX LOT 15-6-2-801

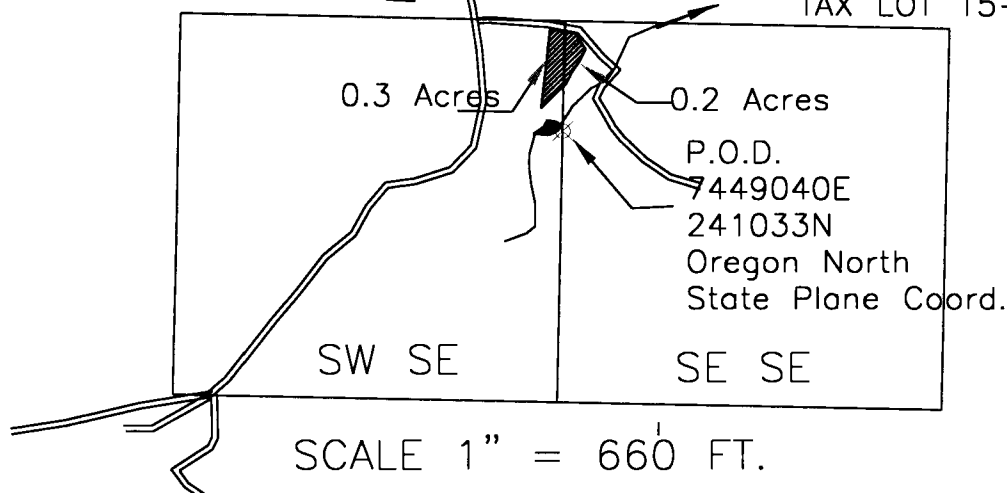


Application No. 80639

Permit No. 52716

In the Name of
James B. Crawford, Jr.

PREPARED BY
Walter L. Trimmer
CWRE#332
9/12/2000

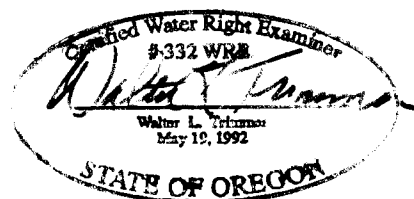

EXD JUN 30 2000