

T.34S.,R.1W.,W.M.



SCALE 1" = 400'



RECEIVED

MAY 01 2000

WATER RESOURCES DEPT
SALEM, OREGON

NW1/4 SE1/4

NOTE: MAP PREPARED FOR
WATER RIGHT PURPOSES ONLY,
NOT FOR PROPERTY BOUNDARY
LOCATIONS.

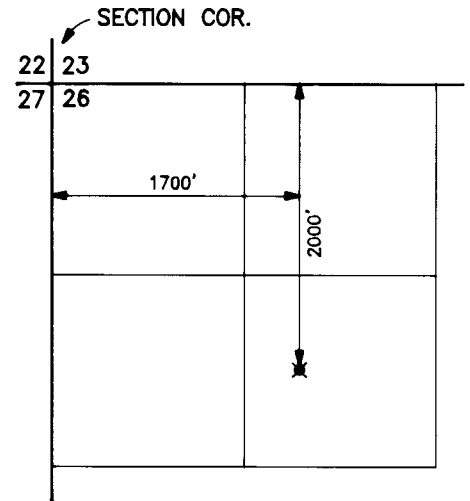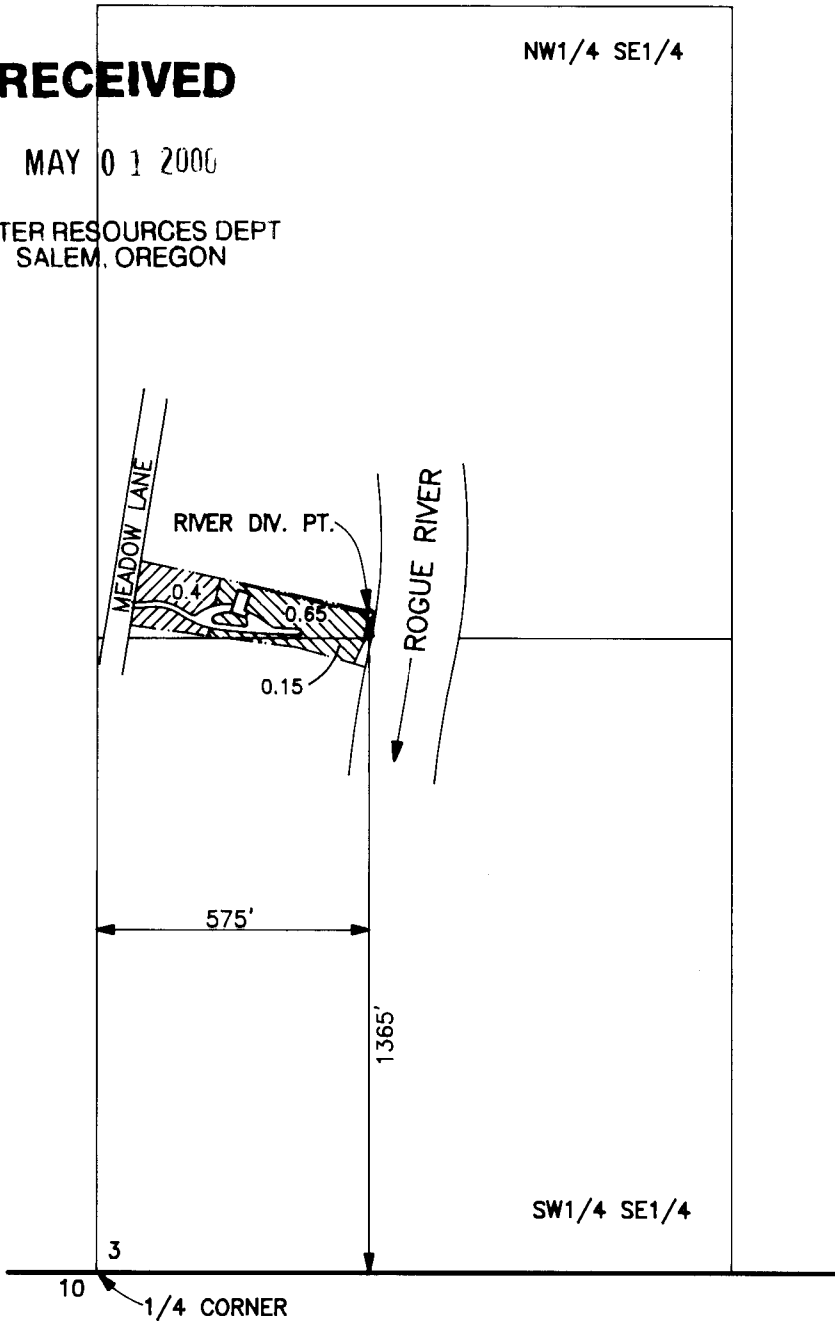

LOST CREEK RESERVOIR
POINT OF DIVERSION
T.33S.,R.1E.,W.M.
SCALE 1" = 1320'

SW1/4 SE1/4

FINAL PROOF MAP

APPLICATION No. S-73428
PERMIT No. 53022

IN THE NAME OF
NICHOLAS D. and
DIANA P. BROUSSARD



= PRIMARY IRRIGATION
SOURCE OF WATER IS
LOST CREEK RES.



= SUPPLEMENTAL IRRIGATION
SOURCE OF WATER IS
LOST CREEK RES.,
PRIMARY IS FROM PERMIT
NO. 18860 SOURCE IS
ROGUE RIVER

MAP PREPARED APRIL 5, 2000 BY GARY D. KAISER

