
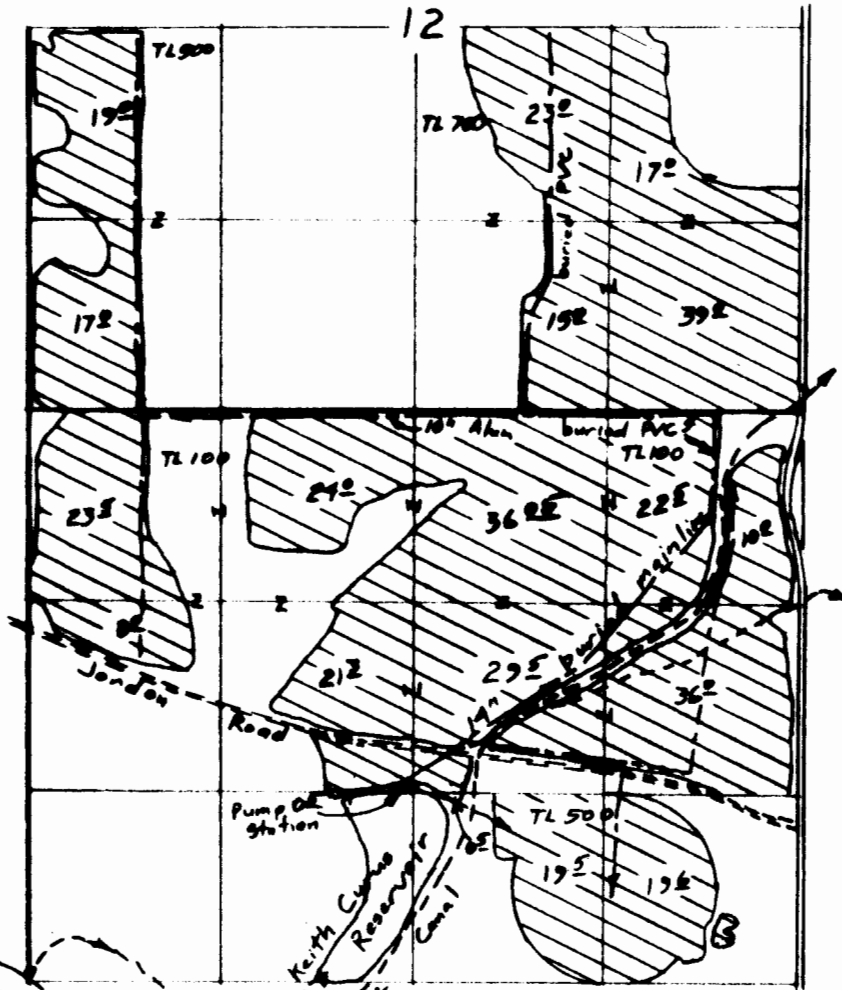


TOWNSHIP 15 SOUTH, RANGE 10 EAST, W.M.

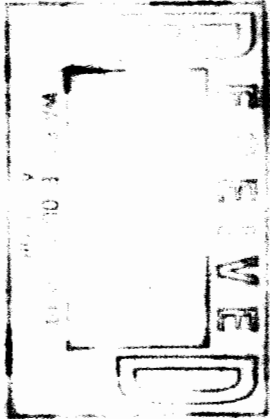

Scale 1" = 1320'


Snow Creek
In Dist. Res.

SCID POD 998' N & 1211' E from SW corner
of Section 21, T.15S., R.10E, W.M.
Cyrus Reservoir 20' N & 70' W from center sec 13

Surveyed Feb 12, 2001

Claim of Beneficial Use Map
for
KEITH CYRUS

App R-69830 & S-69831
Per R-12074 & 52916

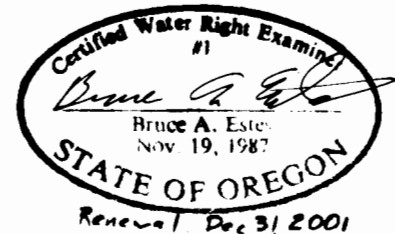

This map is for the purpose of
locating a water right only
and has no intent to provide
legal dimensions or the location
of property lines.

ESTES SURVEYS, LLC
 PO Box 17519 60382 Arnold Rd
 Salem, OR 97305-7519 Bend, OR 97702
 (503) 585-7593 (541) 382-7391