


P. 8087
8081
8983

Twp. 10 S. R. 20. E. W. M.

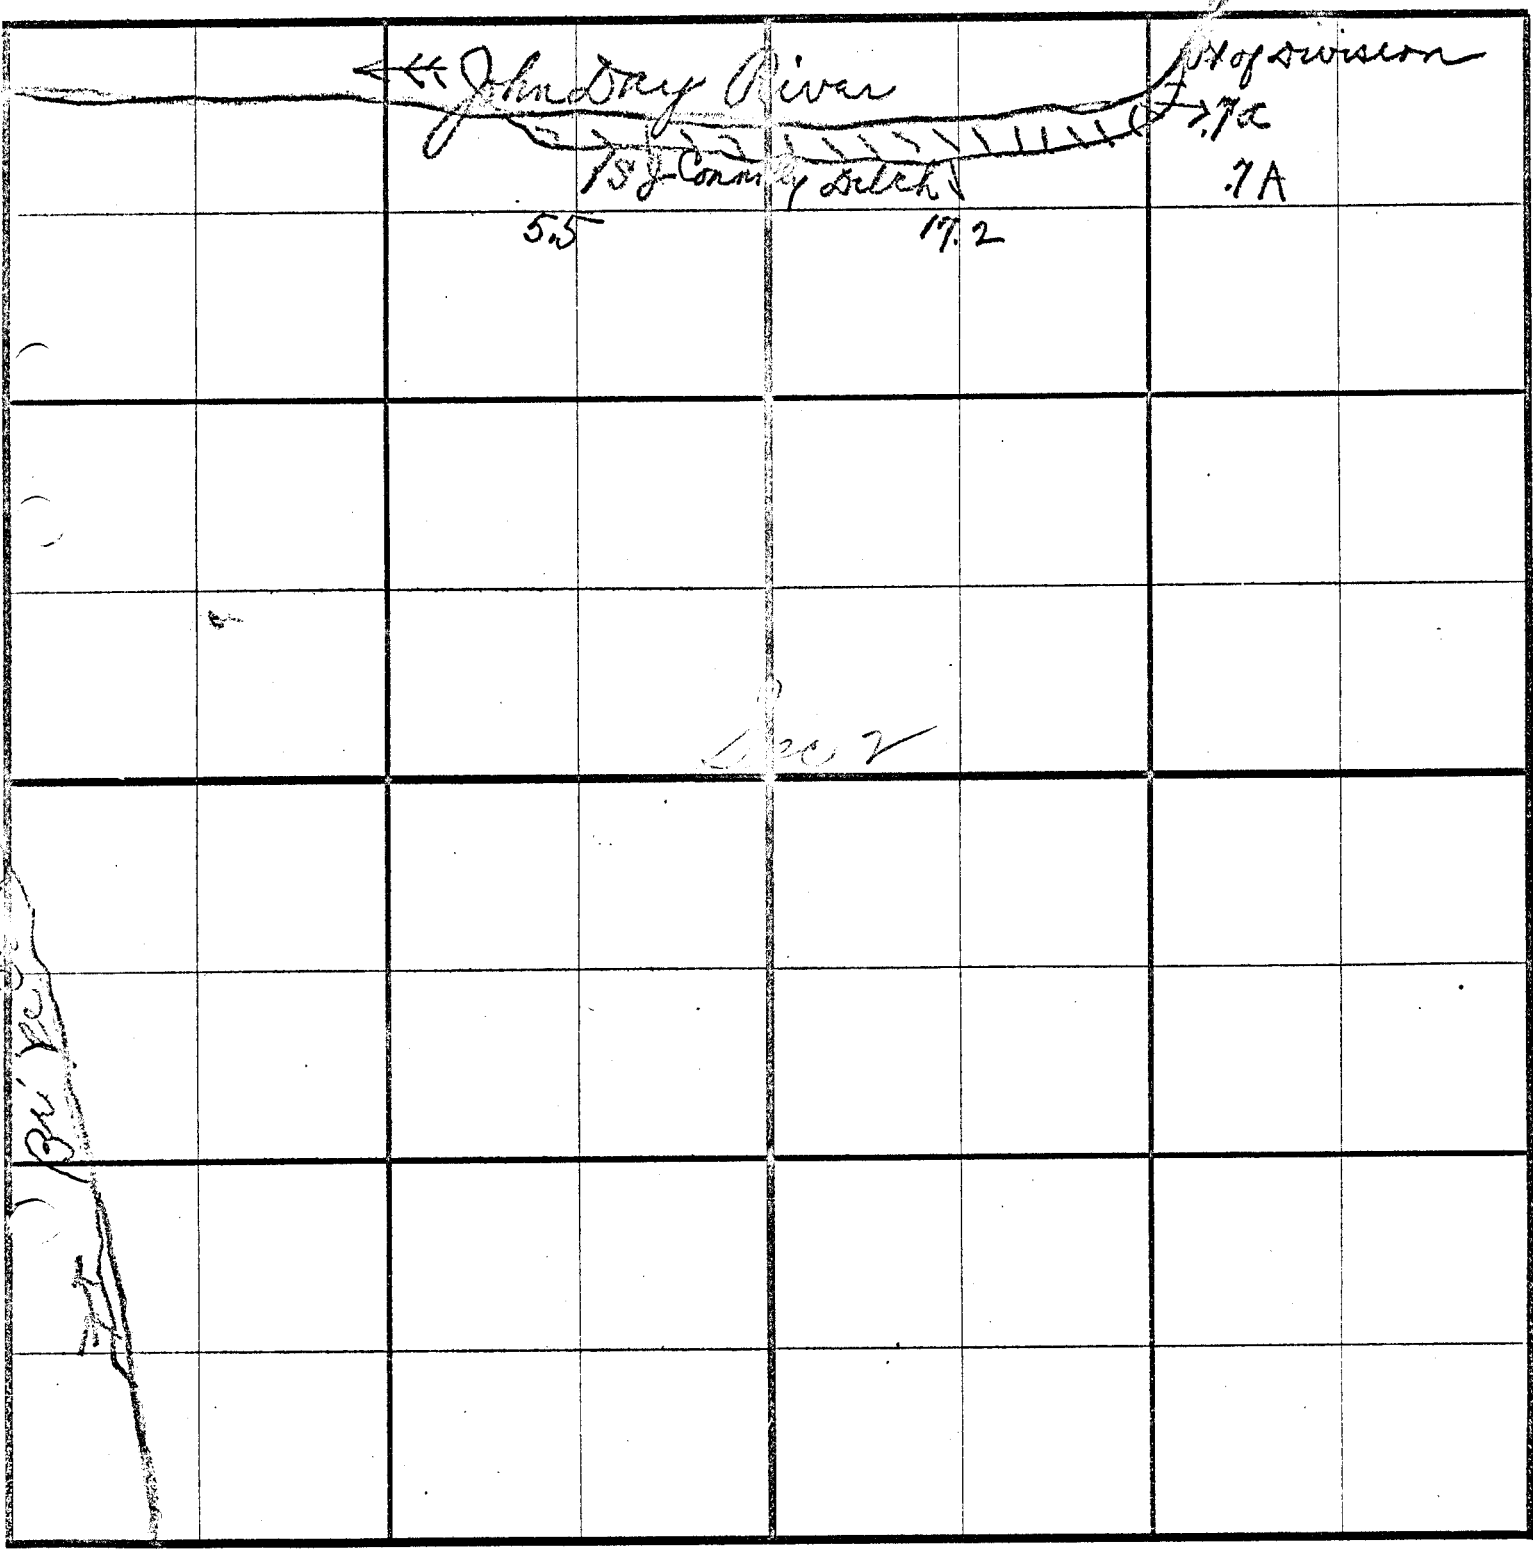

Application No. 11652
Permit No. 8081