



NW 1/4 of NE 1/4 SECTION 27
 SW 1/4 of NE 1/4 SECTION 27
 NW 1/4 of SE 1/4 SECTION 27
 SE 1/4 of NW 1/4 SECTION 27
 T3S, R4E of the WM
 CLACKAMAS COUNTY, OREGON

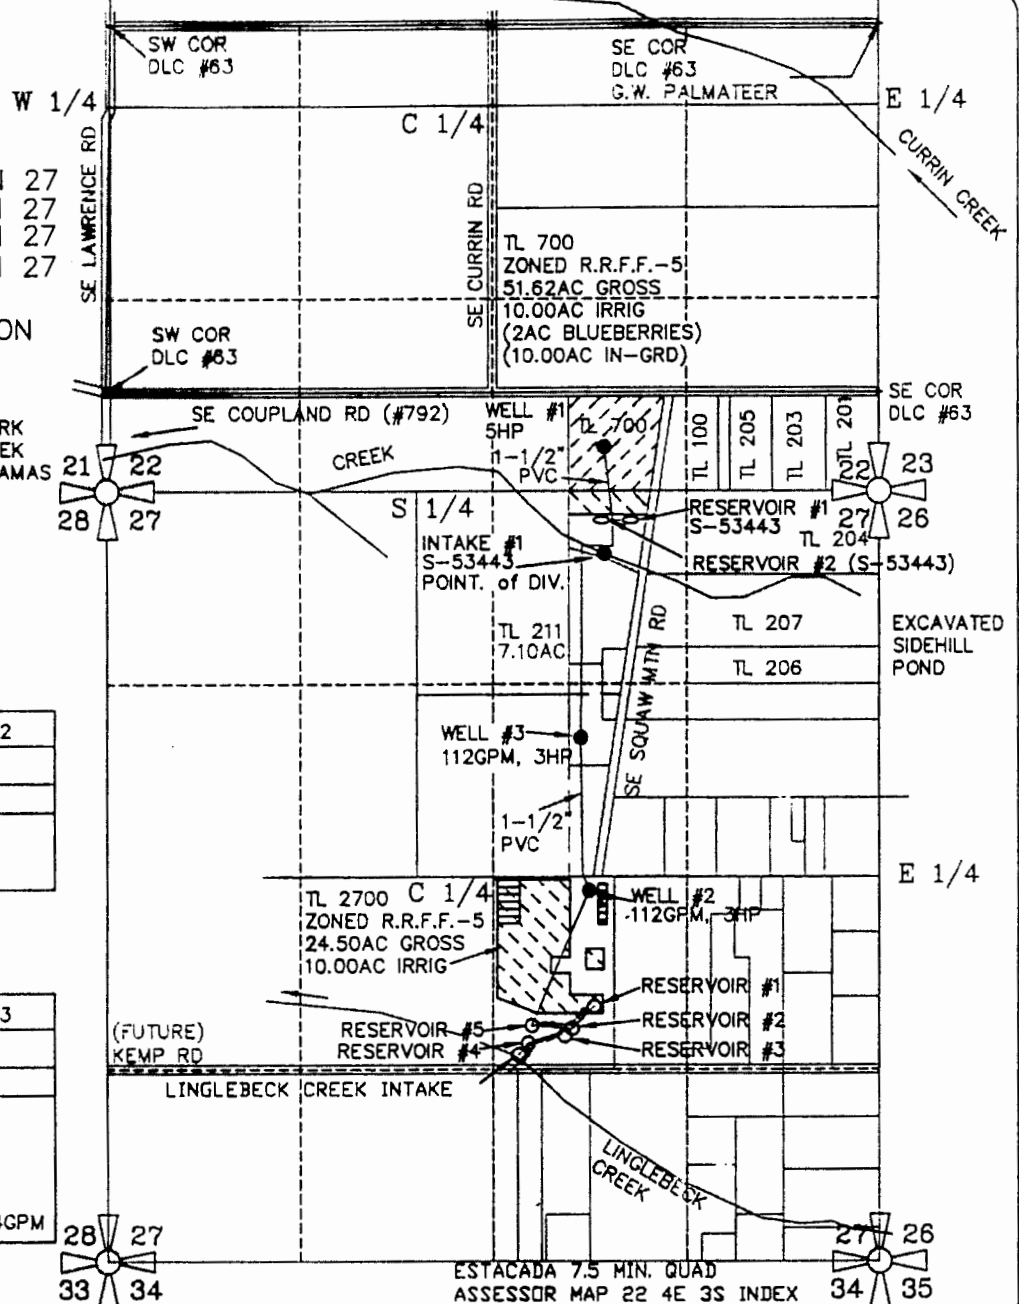


PERMIT S-53442, APPLICATION S-83332			
NURSERY OPERATIONS ON 8 ACRES			
RES.	APPL.	PERMIT	VOLUME
#1	R-83334	R-12512	2.0 AC-FT
#2	R-83625	R-12514	2.0 AC-FT
INT.1	S-83333	S-53443	4.0 AC-FT

PERMIT S-53443, APPLICATION S-83333			
NURSERY OPERATIONS ON 10 ACRES			
RES.	APPL.	PERMIT	VOLUME
#1	R-83332	R-12511	3.00 AC-FT
#2	R-83624	R-12399	1.25 AC-FT
#3	R-83613	R-12515	1.00 AC-FT
#4	R-83622	R-12397	1.25 AC-FT
#5	R-83621	R-12513	1.25 AC-FT
INT.1	S-83332	S-53442	0.13 CFS/58.4GPM

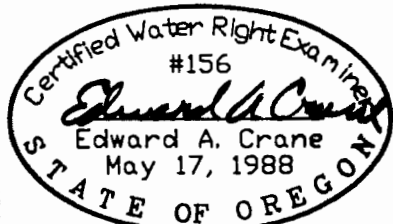

Renewal 12/31/2003
 Signed 5.7.2003

SURVEYED APRIL 8, 2003
 BY EDWARD A. CRANE, CWRE

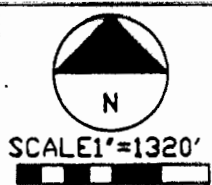

RESERVOIR #1 IS LOCATED 150 FEET SOUTH AND 1690 FEET WEST OF THE NORTHEAST CORNER OF SEC. 27, T.3 S., R.4 E. of the WM
 RESERVOIR #2 IS LOCATED 205 FEET SOUTH AND 1880 FEET WEST OF THE NORTHEAST CORNER OF SEC. 27, T. 3 S., R.4 E. of the WM
 INTAKE #1 IS LOCATED 430 FEET SOUTH AND 1880 FEET WEST OF THE NORTHEAST CORNER OF SEC. 27, T. 3 S., R.4 E. of the WM

PREPARATION OF THIS MAP WAS FOR THE PURPOSE OF IDENTIFYING THE LOCATION OF THE WATER RIGHTS ONLY AND HAS NO INTENT TO PROVIDE DIMENSIONS OR LOCATION OF PROPERTY OWNERSHIP LINES.

FINAL PROOF SURVEY FOR SURFACE WATER PERMITS S-53442 & S-53443

DATE
 MAY 2003
 PROJECT NO.
 455-002



CRANE & MERSETH
 Engineering/Surveying
 SUITE 'D'
 6566 SE LAKE ROAD
 MILWAUKIE, OREGON 97222
 BUS: (503) 654-2005
 FAX: (503) 654-2575

APPLICATION FOR PERMIT NO. S-83332 & 3
 PERMIT NUMBER S-53442 & 3 IN THE NAME OF
 BEN J. FRANKLIN & LISA MARIE HOPKINS
 BEN FRANKLIN NURSERY (TEL: 503-630-6627)
 35674 SE SQUAW MTN RD, ESTACADA, OREGON

SHEET
 1/1