

NW 1/4 of NE 1/4 SECTION 27
 SW 1/4 of NE 1/4 SECTION 27
 NW 1/4 of SE 1/4 SECTION 27
 SE 1/4 of NW 1/4 SECTION 27
 T3S, R4E of the WM
 CLACKAMAS COUNTY, OREGON

W 1/4

C 1/4

E 1/4

SW COR
DLC #63

SE COR
DLC #63
G.W. PALMATEER

NORTH FORK
WADE CREEK
TO CLACKAMAS
RIVER

21 22
28 27

SE COUPLAND RD (#792)
CREEK
WELL #1
5HP
1-1/2" PVC

TL 700
ZONED R.R.F.-5
51.62AC GROSS
10.00AC IRRIG
(2AC BLUEBERRIES)
(10.00AC IN-GRD)

TL 100
TL 205
TL 203
TL 204

SE COR
DLC #63

RESERVOIR #1
S-53443
TL 204
RESERVOIR #2 (S-53443)

EXCAVATED
SIDEHILL
POND

WELL #3
112GPM, 3HP
1-1/2" PVC

TL 211
7.10AC

TL 207
TL 206

E 1/4

TL 2700 C 1/4
ZONED R.R.F.-5
24.50AC GROSS
10.00AC IRRIG

WELL #2
112GPM, 3HP

RESERVOIR #1
RESERVOIR #2
RESERVOIR #3

(FUTURE)
KEMP RD

LINGLEBECK CREEK INTAKE

LINGLEBECK
CREEK

28 27
33 34

ESTACADA 7.5 MIN. QUAD
ASSESSOR MAP 22 4E 3S INDEX

27 26
34 35

PERMIT S-53442, APPLICATION S-83332


NURSERY OPERATIONS ON 8 ACRES

RES.	APPL.	PERMIT	VOLUME
#1	R-83334	R-12512	2.0 AC-FT
#2	R-83625	R-12514	2.0 AC-FT
INT.1	S-83333	S-53443	4.0 AC-FT

PERMIT S-53443, APPLICATION S-83333


NURSERY OPERATIONS ON 10 ACRES

RES.	APPL.	PERMIT	VOLUME
#1	R-83332	R-12511	3.00 AC-FT
#2	R-83624	R-12399	1.25 AC-FT
#3	R-83613	R-12515	1.00 AC-FT
#4	R-83622	R-12397	1.25 AC-FT
#5	R-83621	R-12513	1.25 AC-FT
INT.1	S-83332	S-53442	0.13 CFS/58.4GPM

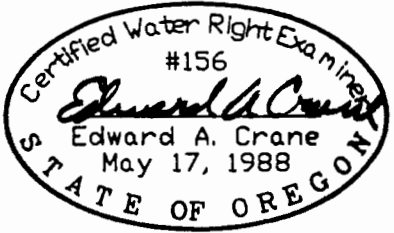

Renewal 12/31/2003
 Signed 5.7.2003

SURVEYED APRIL 8, 2003
 BY EDWARD A. CRANE, CWRE

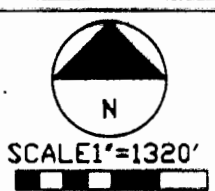

RESERVOIR #1 IS LOCATED 150 FEET SOUTH AND 1690 FEET WEST OF THE NORTHEAST CORNER OF SEC. 27, T.3 S., R.4 E. of the WM
 RESERVOIR #2 IS LOCATED 205 FEET SOUTH AND 1880 FEET WEST OF THE NORTHEAST CORNER OF SEC. 27, T. 3 S., R.4 E. of the WM
 INTAKE #1 IS LOCATED 430 FEET SOUTH AND 1880 FEET WEST OF THE NORTHEAST CORNER OF SEC. 27, T. 3 S., R.4 E. of the WM

PREPARATION OF THIS MAP WAS FOR THE PURPOSE OF IDENTIFYING THE LOCATION OF THE WATER RIGHTS ONLY AND HAS NO INTENT TO PROVIDE DIMENSIONS OR LOCATION OF PROPERTY OWNERSHIP LINES.

FINAL PROOF SURVEY FOR SURFACE WATER PERMITS S-53442 & S-53443

DATE

MAY 2003

PROJECT NO.

455-002



CRANE & MERSETH
 Engineering/Surveying
 SUITE 'D'
 6566 SE LAKE ROAD
 MILWAUKIE, OREGON 97222
 BUS: (503) 654-2005
 FAX: (503) 654-2575

APPLICATION FOR PERMIT NO. S-83332 & 3

PERMIT NUMBER S-53442 & 3 IN THE NAME OF

BEN J. FRANKLIN & LISA MARIE HOPKINS
 BEN FRANKLIN NURSERY (TEL: 503-630-6627)
 35674 SE SQUAW MTN RD, ESTACADA, OREGON

SHEET

1/1