

NW 1/4 of NE 1/4 SECTION 27
 SW 1/4 of NE 1/4 SECTION 27
 NW 1/4 of SE 1/4 SECTION 27
 SE 1/4 of NW 1/4 SECTION 27
 T3S, R4E of the WM
 CLACKAMAS COUNTY, OREGON

NORTH FORK
 WADE CREEK
 TO CLACKAMAS
 RIVER

PERMIT S-53442, APPLICATION S-83332


NURSERY OPERATIONS ON 8 ACRES

RES.	APPL.	PERMIT	VOLUME
#1	R-83334	R-12512	2.0 AC-FT
#2	R-83625	R-12514	2.0 AC-FT
INT.1	S-83333	S-53443	4.0 AC-FT

PERMIT S-53443, APPLICATION S-83333

NURSERY OPERATIONS ON 10 ACRES


RES.	APPL.	PERMIT	VOLUME
#1	R-83332	R-12511	3.00 AC-FT
#2	R-83624	R-12399	1.25 AC-FT
#3	R-83613	R-12515	1.00 AC-FT
#4	R-83622	R-12397	1.25 AC-FT
#5	R-83621	R-12513	1.25 AC-FT
INT.1	S-83332	S-53442	0.13 CFS/58.4GPM

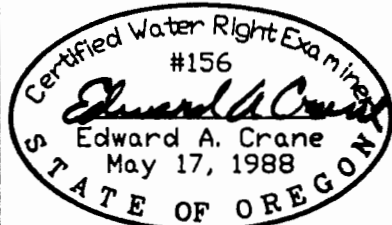

Renewal 12/31/2003

Signed 5.7.2003

SURVEYED APRIL 8, 2003
 BY EDWARD A. CRANE, CWRE

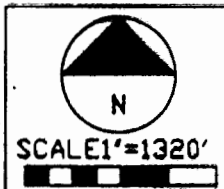

PREPARATION OF THIS MAP WAS FOR THE PURPOSE
 OF IDENTIFYING THE LOCATION OF THE WATER RIGHTS
 ONLY AND HAS NO INTENT TO PROVIDE DIMENSIONS
 OR LOCATION OF PROPERTY OWNERSHIP LINES.

FINAL PROOF SURVEY FOR SURFACE
 WATER PERMITS S-53442 & S-53443

DATE

MAY 2003

PROJECT NO.

455-002



CRANE & MERSETH
 Engineering/Surveying
 SUITE 'D'
 6566 SE LAKE ROAD
 MILWAUKIE, OREGON 97222
 BUS: (503) 654-2005
 FAX: (503) 654-2575

APPLICATION FOR PERMIT NO. S-83332 & 3

PERMIT NUMBER S-53442 & 3 IN THE NAME OF

BEN J. FRANKLIN & LISA MARIE HOPKINS
 BEN FRANKLIN NURSERY (TEL: 503-630-6627)
 35674 SE SQUAW MTN RD, ESTACADA, OREGON

SHEET

1/1

