
NW 1/4 of NE 1/4 SECTION 27
SW 1/4 of NE 1/4 SECTION 27
NW 1/4 of SE 1/4 SECTION 27
SE 1/4 of NW 1/4 SECTION 27
T3S, R4E of the WM
CLACKAMAS COUNTY, OREGON

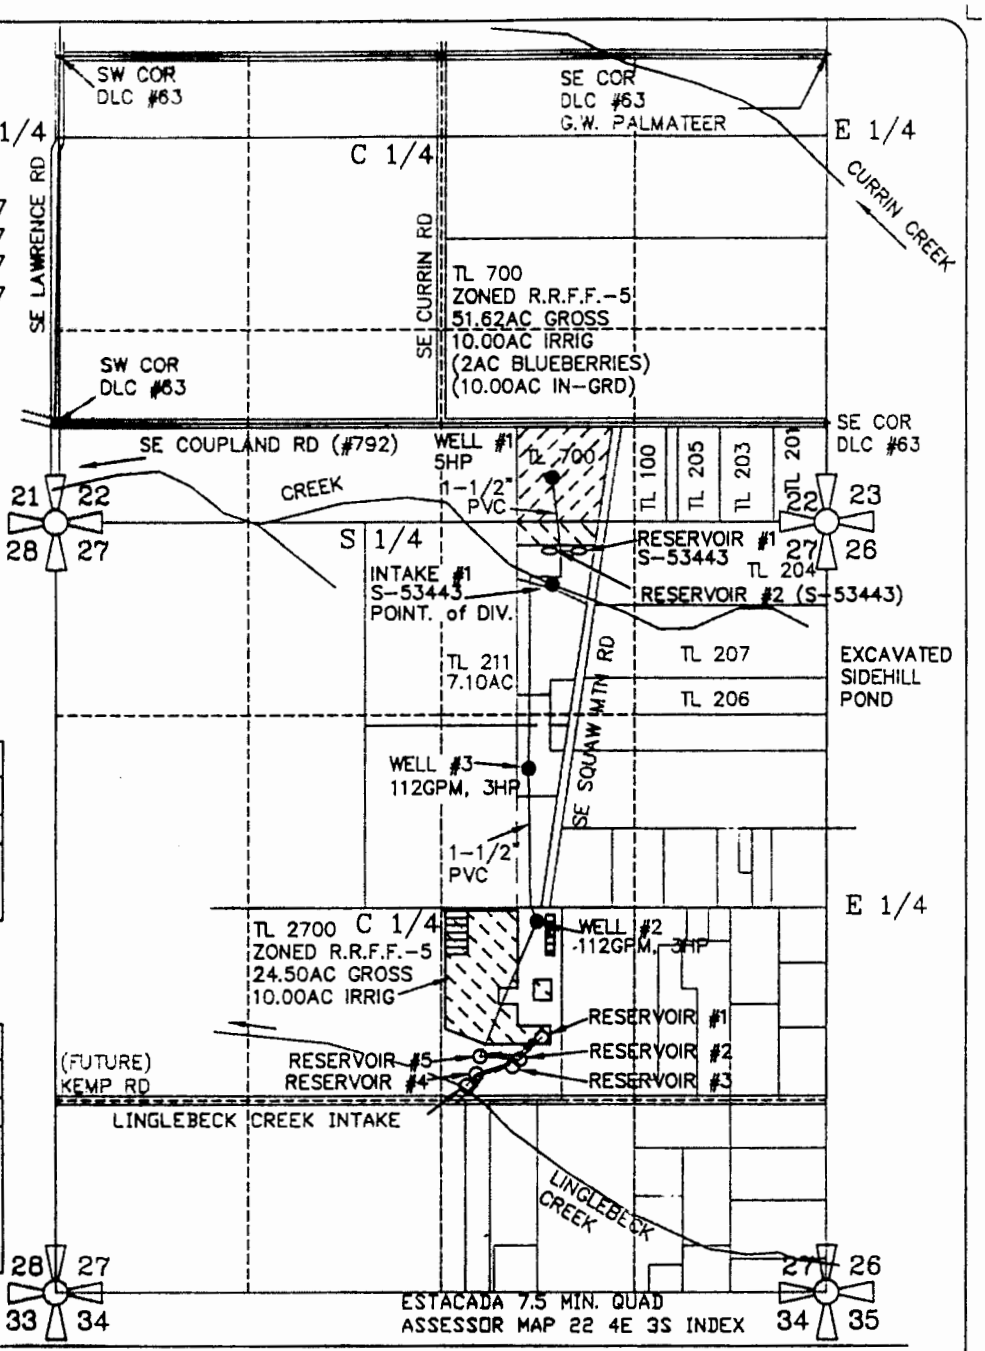

PERMIT S-53442, APPLICATION S-83332			
NURSERY OPERATIONS ON 8 ACRES			
RES.	APPL.	PERMIT	VOLUME
#1	R-83334	R-12512	2.0 AC-FT
#2	R-83625	R-12514	2.0 AC-FT
INT.1	S-83333	S-53443	4.0 AC-FT

PERMIT S-53443, APPLICATION S-83333			
NURSERY OPERATIONS ON 10 ACRES			
RES.	APPL.	PERMIT	VOLUME
#1	R-83332	R-12511	3.00 AC-FT
#2	R-83624	R-12399	1.25 AC-FT
#3	R-83613	R-12515	1.00 AC-FT
#4	R-83622	R-12397	1.25 AC-FT
#5	R-83621	R-12513	1.25 AC-FT
INT.1	S-83332	S-53442	0.13 CFS/58.4GPM

RESERVOIR #1 IS LOCATED 150 FEET SOUTH AND 1690 FEET WEST OF THE NORTHEAST CORNER OF SEC. 27, T.3 S., R.4 E. of the WM
RESERVOIR #2 IS LOCATED 205 FEET SOUTH AND 1880 FEET WEST OF THE NORTHEAST CORNER OF SEC. 27, T. 3 S., R.4 E. of the WM
INTAKE #1 IS LOCATED 430 FEET SOUTH AND 1880 FEET WEST OF THE NORTHEAST CORNER OF SEC. 27, T. 3 S., R.4 E. of the WM

Certified Water Right Examiner
#156
Edward A. Crane
May 17, 1988
STATE OF OREGON

Renewal 12/31/2003
Signed 5.7.2003

SURVEYED APRIL 8, 2003
BY EDWARD A. CRANE, CWRE

N
SCALE 1"=1320'

PREPARATION OF THIS MAP WAS FOR THE PURPOSE OF IDENTIFYING THE LOCATION OF THE WATER RIGHTS ONLY AND HAS NO INTENT TO PROVIDE DIMENSIONS OR LOCATION OF PROPERTY OWNERSHIP LINES.

FINAL PROOF SURVEY FOR SURFACE WATER PERMITS S-53442 & S-53443

DATE: MAY 2003	CRANE & MERSETH Engineering/Surveying SUITE 'D' 6566 SE LAKE ROAD MILWAUKIE, OREGON 97222 BUS: (503) 654-2005 FAX: (503) 654-2575	APPLICATION FOR PERMIT NO. S-83332 & 3 PERMIT NUMBER S-53442 & 3 IN THE NAME OF: BEN J. FRANKLIN & LISA MARIE HOPKINS BEN FRANKLIN NURSERY (TEL: 503-630-6627) 35674 SE SQUAW MTN RD, ESTACADA, OREGON	SHEET 1/1
PROJECT NO. 455-002			