

NW 1/4 of NE 1/4 SECTION 27
 SW 1/4 of NE 1/4 SECTION 27
 NW 1/4 of SE 1/4 SECTION 27
 SE 1/4 of NW 1/4 SECTION 27
 T3S, R4E of the WM
 CLACKAMAS COUNTY, OREGON

W 1/4

C 1/4

E 1/4

SE LAWRENCE RD

SE CURRIN RD

CURRIN CREEK

NORTH FORK
 WADE CREEK
 TO CLACKAMAS
 RIVER

21 22
 28 27

SW COR
 DLC #63

SE COR
 DLC #63
 G.W. PALMATEER

TL 700
 ZONED R.R.F.F.-5
 51.62AC GROSS
 10.00AC IRRIG
 (2AC BLUEBERRIES)
 (10.00AC IN-GRD)

SW COR
 DLC #63

SE COUPLAND RD (#792)

WELL #1
 5HP
 1-1/2" PVC

TL 100

TL 205

TL 203

TL 201

SE COR
 DLC #63

RESERVOIR #1
 S-53443

RESERVOIR #2 (S-53443)

INTAKE #1
 S-53443
 POINT. of DIV.

TL 211
 7.10AC

TL 207

TL 206

EXCAVATED
 SIDEHILL
 POND

WELL #3
 112GPM, 3HP

1-1/2" PVC

E 1/4

TL 2700 C 1/4
 ZONED R.R.F.F.-5
 24.50AC GROSS
 10.00AC IRRIG

WELL #2
 112GPM, 3HP

RESERVOIR #1

RESERVOIR #2

RESERVOIR #3

RESERVOIR #4

RESERVOIR #5

(FUTURE)
 KEMP RD

LINGLEBECK CREEK INTAKE

LINGLEBECK
 CREEK

28 27
 33 34

ESTACADA 7.5 MIN. QUAD
 ASSESSOR MAP 22 4E 3S INDEX

27 26
 34 35

PERMIT S-53442, APPLICATION S-83332


NURSERY OPERATIONS ON 8 ACRES

RES.	APPL.	PERMIT	VOLUME
#1	R-83334	R-12512	2.0 AC-FT
#2	R-83625	R-12514	2.0 AC-FT
INT.1	S-83333	S-53443	4.0 AC-FT

PERMIT S-53443, APPLICATION S-83333

NURSERY OPERATIONS ON 10 ACRES

RES.	APPL.	PERMIT	VOLUME
#1	R-83332	R-12511	3.00 AC-FT
#2	R-83624	R-12399	1.25 AC-FT
#3	R-83613	R-12515	1.00 AC-FT
#4	R-83622	R-12397	1.25 AC-FT
#5	R-83621	R-12513	1.25 AC-FT
INT.1	S-83332	S-53442	0.13 CFS/58.4GPM

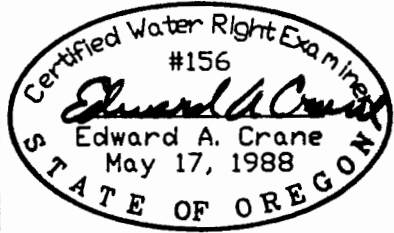

Renewal 12/31/2003
 Signed 5.7.2003

SURVEYED APRIL 8, 2003
 BY EDWARD A. CRANE, CWRE



SCALE 1"=1320'

RESERVOIR #1 IS LOCATED 150 FEET SOUTH AND 1690 FEET WEST
 OF THE NORTHEAST CORNER OF SEC. 27, T.3 S., R.4 E. of the WM
 RESERVOIR #2 IS LOCATED 205 FEET SOUTH AND 1880 FEET WEST
 OF THE NORTHEAST CORNER OF SEC. 27, T. 3 S., R.4 E. of the WM
 INTAKE #1 IS LOCATED 430 FEET SOUTH AND 1880 FEET WEST
 OF THE NORTHEAST CORNER OF SEC. 27, T. 3 S., R.4 E. of the WM

PREPARATION OF THIS MAP WAS FOR THE PURPOSE
 OF IDENTIFYING THE LOCATION OF THE WATER RIGHTS
 ONLY AND HAS NO INTENT TO PROVIDE DIMENSIONS
 OR LOCATION OF PROPERTY OWNERSHIP LINES.

FINAL PROOF SURVEY FOR SURFACE
 WATER PERMITS S-53442 & S-53443

DATE

MAY 2003

PROJECT NO.

455-002



CRANE & MERSEETH
 Engineering/Surveying
 SUITE 'D'
 6566 SE LAKE ROAD
 MILWAUKIE, OREGON 97222
 BUS: (503) 654-2005
 FAX: (503) 654-2575

APPLICATION FOR PERMIT NO. S-83332 & 3

PERMIT NUMBER S-53442 & 3 IN THE NAME OF

BEN J. FRANKLIN & LISA MARIE HOPKINS
 BEN FRANKLIN NURSERY (TEL: 503-630-6627)
 35674 SE SQUAW MTN RD, ESTACADA, OREGON

SHEET

1/1