


T.2S., R.4E., W.M.

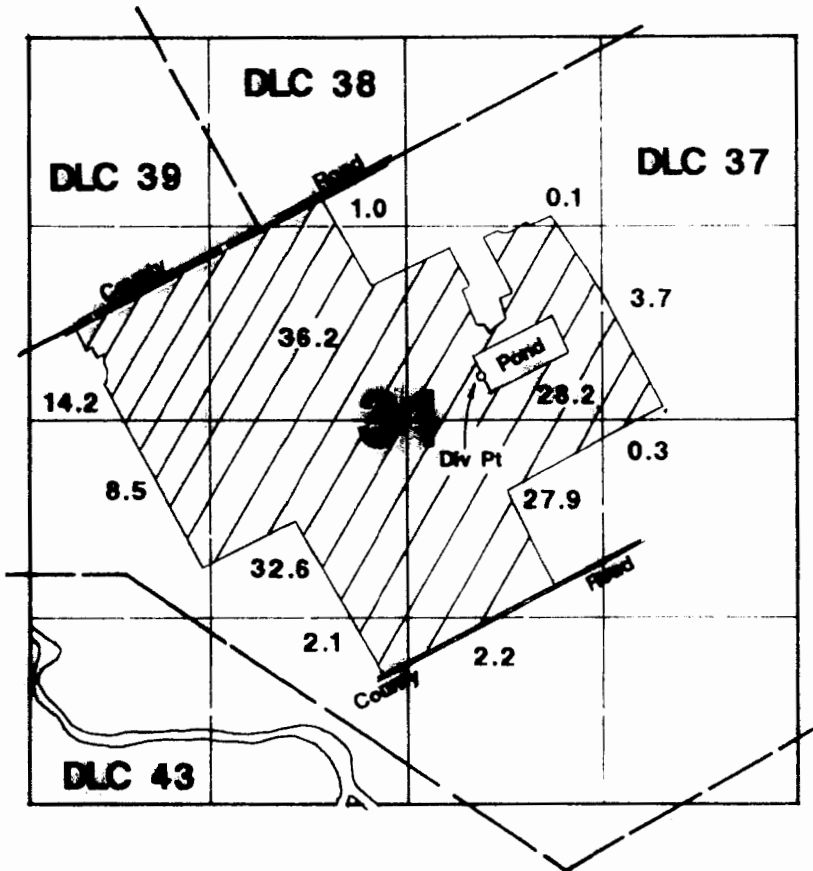

Div Pt (Pond) located 290'N & 500'E from center of Section 31.

Final Proof Survey

Application: 70578
70579

Permit: R-11353
51196

In Name Of

David Timm

Surveyed November 21, 1992 by Jim Grimm



RECORDS OF THE COUNTY OF
