
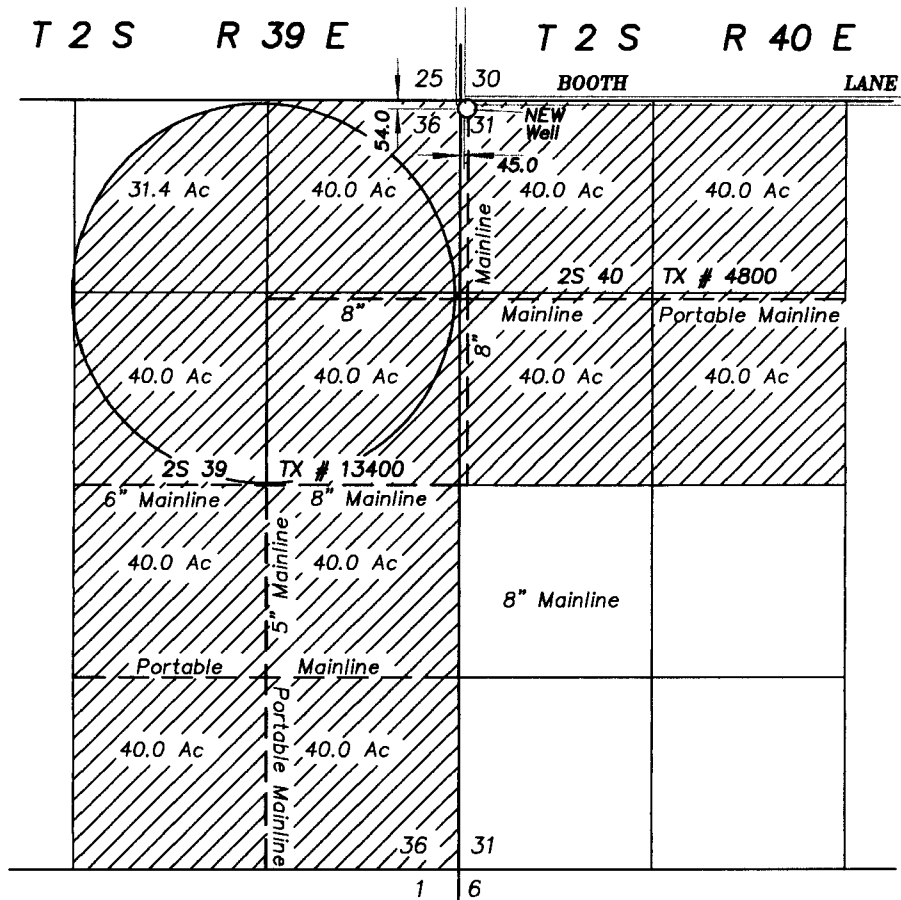


Primary lands being irrigated  
from new well.

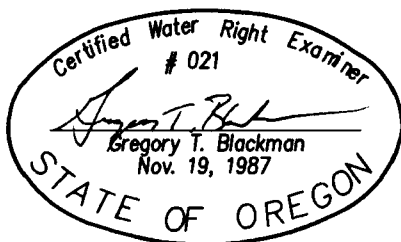

NOTE: The preparation of this map was for the purpose of identifying the location of the proposed water right and has no intent to provide dimensions or location of property ownership lines. Location information shown hereon was furnished by the applicant.

**RECEIVED**

SEP 28 2000

WATER RESOURCES DEPT.  
SALEM, OREGON

# FINAL PROOF MAP OF WATER RIGHTS FOR TERRY PUCKETT

BY  
BAGETT - GRIFFITH & BLACKMAN  
2006 ADAMS AVENUE  
LAGRANDE, OREGON 97850

April 11, 2000

APPLICATION NO. G- 14000  
PERMIT NUMBER G- 12696