


RECEIVED

SEP 21 1994

WATER RESOURCES DEPT.
SALEM, OREGON

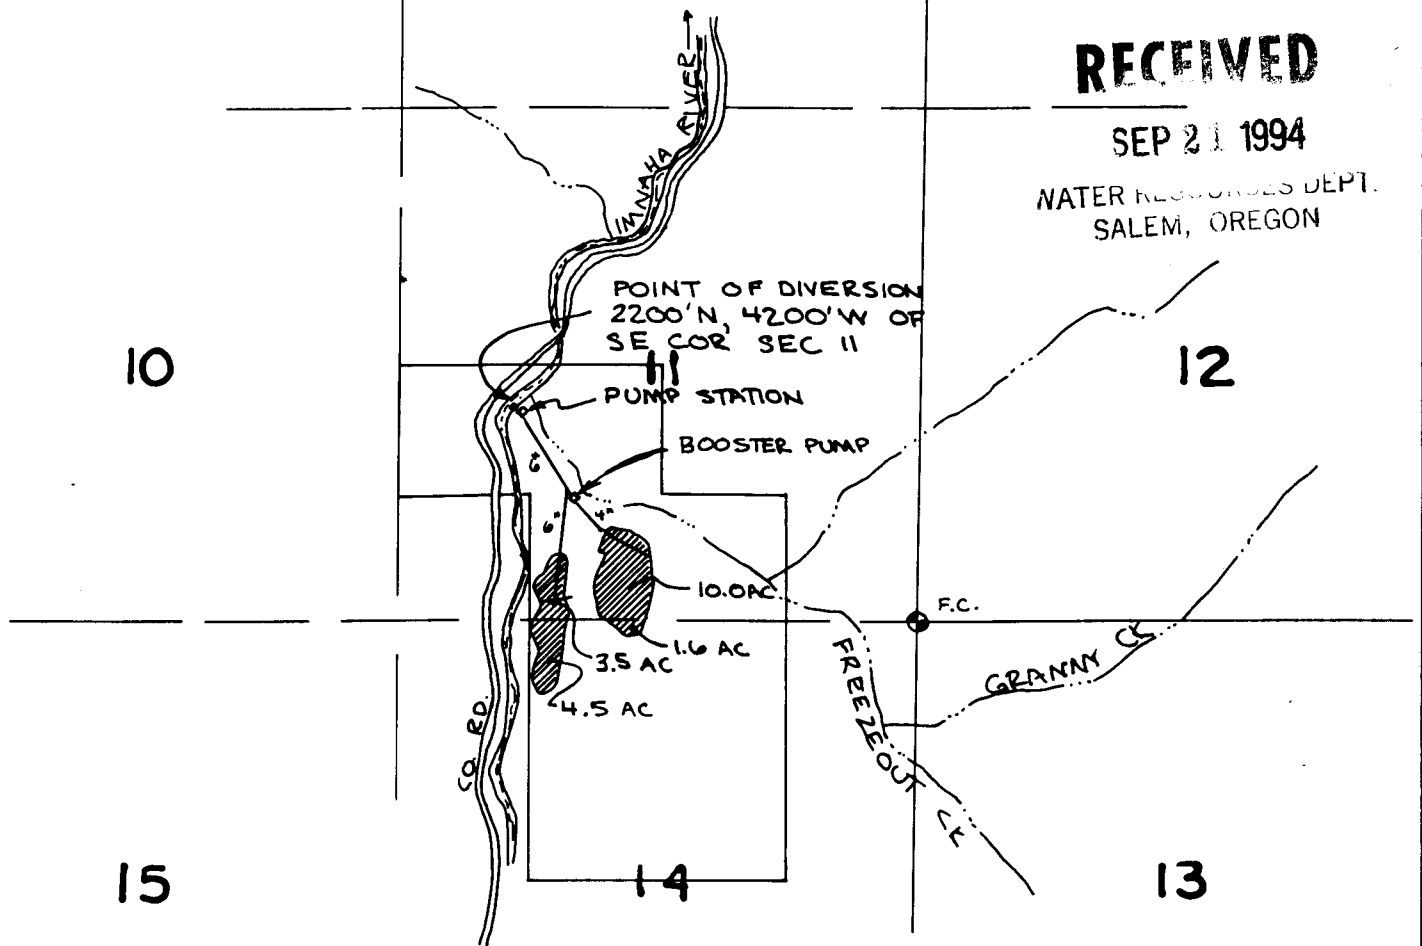

LANDS IRRIGATED UNDER
PERMIT NO. 51131

SE 1/4 SW 1/4 SEC 11	13.5 AC
NE 1/4 NW 1/4 SEC 14	6.1 AC
TOTAL	19.6 AC

THE SOURCE OF WATER IS THE
IMNAHA RIVER. THE POINT OF
DIVERSION IS 2200' N AND 4200' W
OF THE SE COR. SEC 11 AS DETER-
MINED FROM USGS ORTHOPHOTOQUAD




1" = 2000 FT

SEC 11 & 14
T2S, R48E WM

THIS MAP WAS PREPARED FOR WATER RIGHT
PURPOSES ONLY AND SHOULD NOT BE
USED FOR PROPERTY LINE LOCATION.

BASE MAP PREPARED FROM WALLOWA CO
ASSESSOR MAP 2S 48

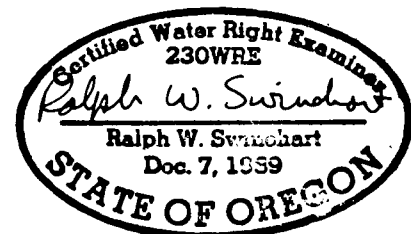

App. 70280
Per. 51131

9/14/94

IN SEC 11 & 14
T 2S R 48E, WM
WALLOWA COUNTY

FINAL PROOF SURVEY
FOR: BRAGG INVESTMENT CO.
IMNAHA, OREGON