


Township 13 South, Range 29 East, W.M.

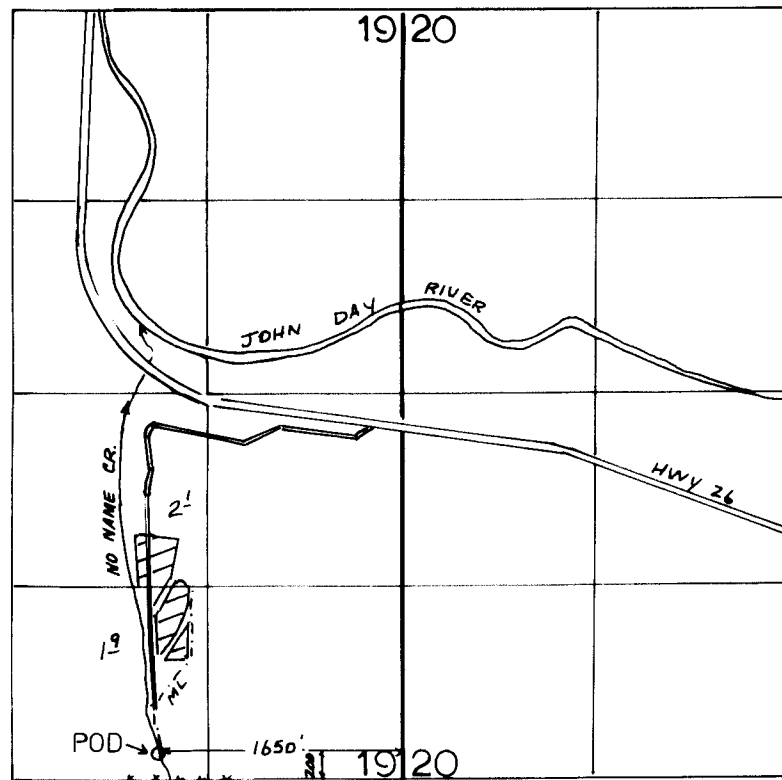

1" = 1320'

**FINAL PROOF SURVEY
UNDER**

**Application No. 89008.. Permit No. 50023.....
IN NAME OF**

.....JOHN AND JUDY PEGG.....

Surveyed SEPT..9. 1999., by J.MILLER.....