


Township 13 South, Range 30 East, W. M.

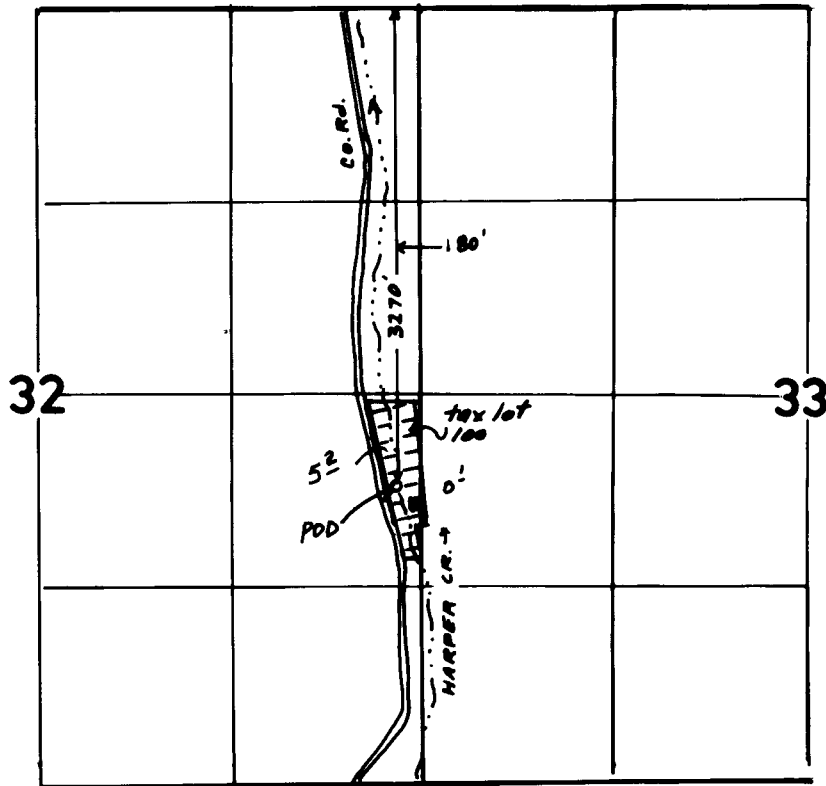

1" = 1320'

**FINAL PROOF SURVEY
UNDER**

**Application No. 69067.. Permit No. 49991.....
IN NAME OF**

...EDWARD E. & PENELOPE L. BENNETTE...

Surveyed JULY 30 1999., by JUNE MILLER..