


T 24 S, R 32 E, WM

RECEIVED

WATER RIGHTS
SALEM, OREGON

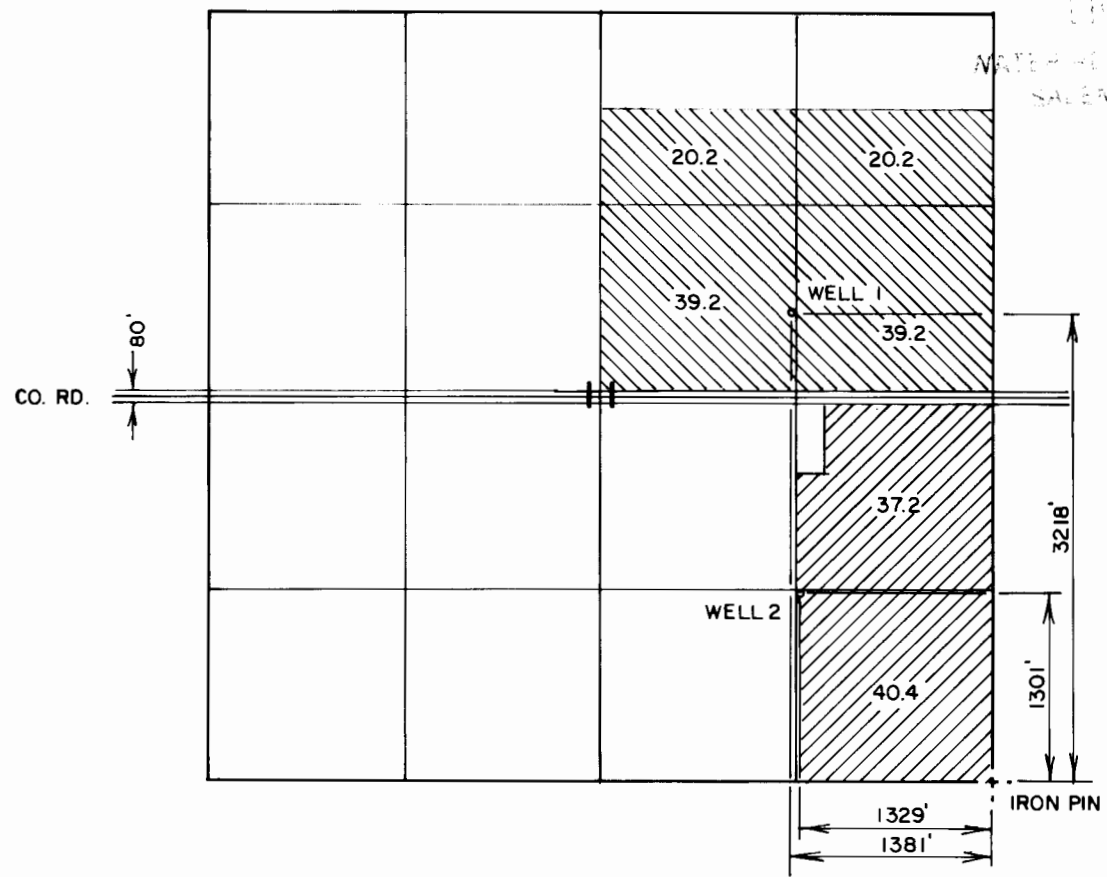


THE PURPOSE OF THIS MAP IS TO IDENTIFY THE LOCATION OF THE WATER RIGHT. IT IS NOT INTENDED TO PROVIDE INFORMATION RELATIVE TO THE LOCATION OF PROPERTY OWNERSHIP.



FINAL PROOF SURVEY

UNDER APPLICATION G-12463
PERMIT G-11785

IN THE NAME OF
CURTIS J. BLACKBURN

Scale: 4" = 1 MILE	Date: JAN. 1996	Job: 1295
Dsn:	 M. A. PALMER & SONS, INC. ENGINEERING & SURVEYING 254 N. Alder - Box 61 Burns, Oregon 97720	Sht. No.
Drn: CHRIS		of 1
Ckd:		