

Original Map in 72231
T.35S., R.2W., W.M.

FINAL PROOF MAP

APPLICATION No. S-72231
PERMIT No. 52634

IN THE NAME OF
Scott C. Folin


AND

APPLICATION No. S-72204
PERMIT No. 52900

IN THE NAME OF
Sams Valley Irrigation Association (SVIA)



SCALE 1" = 400'

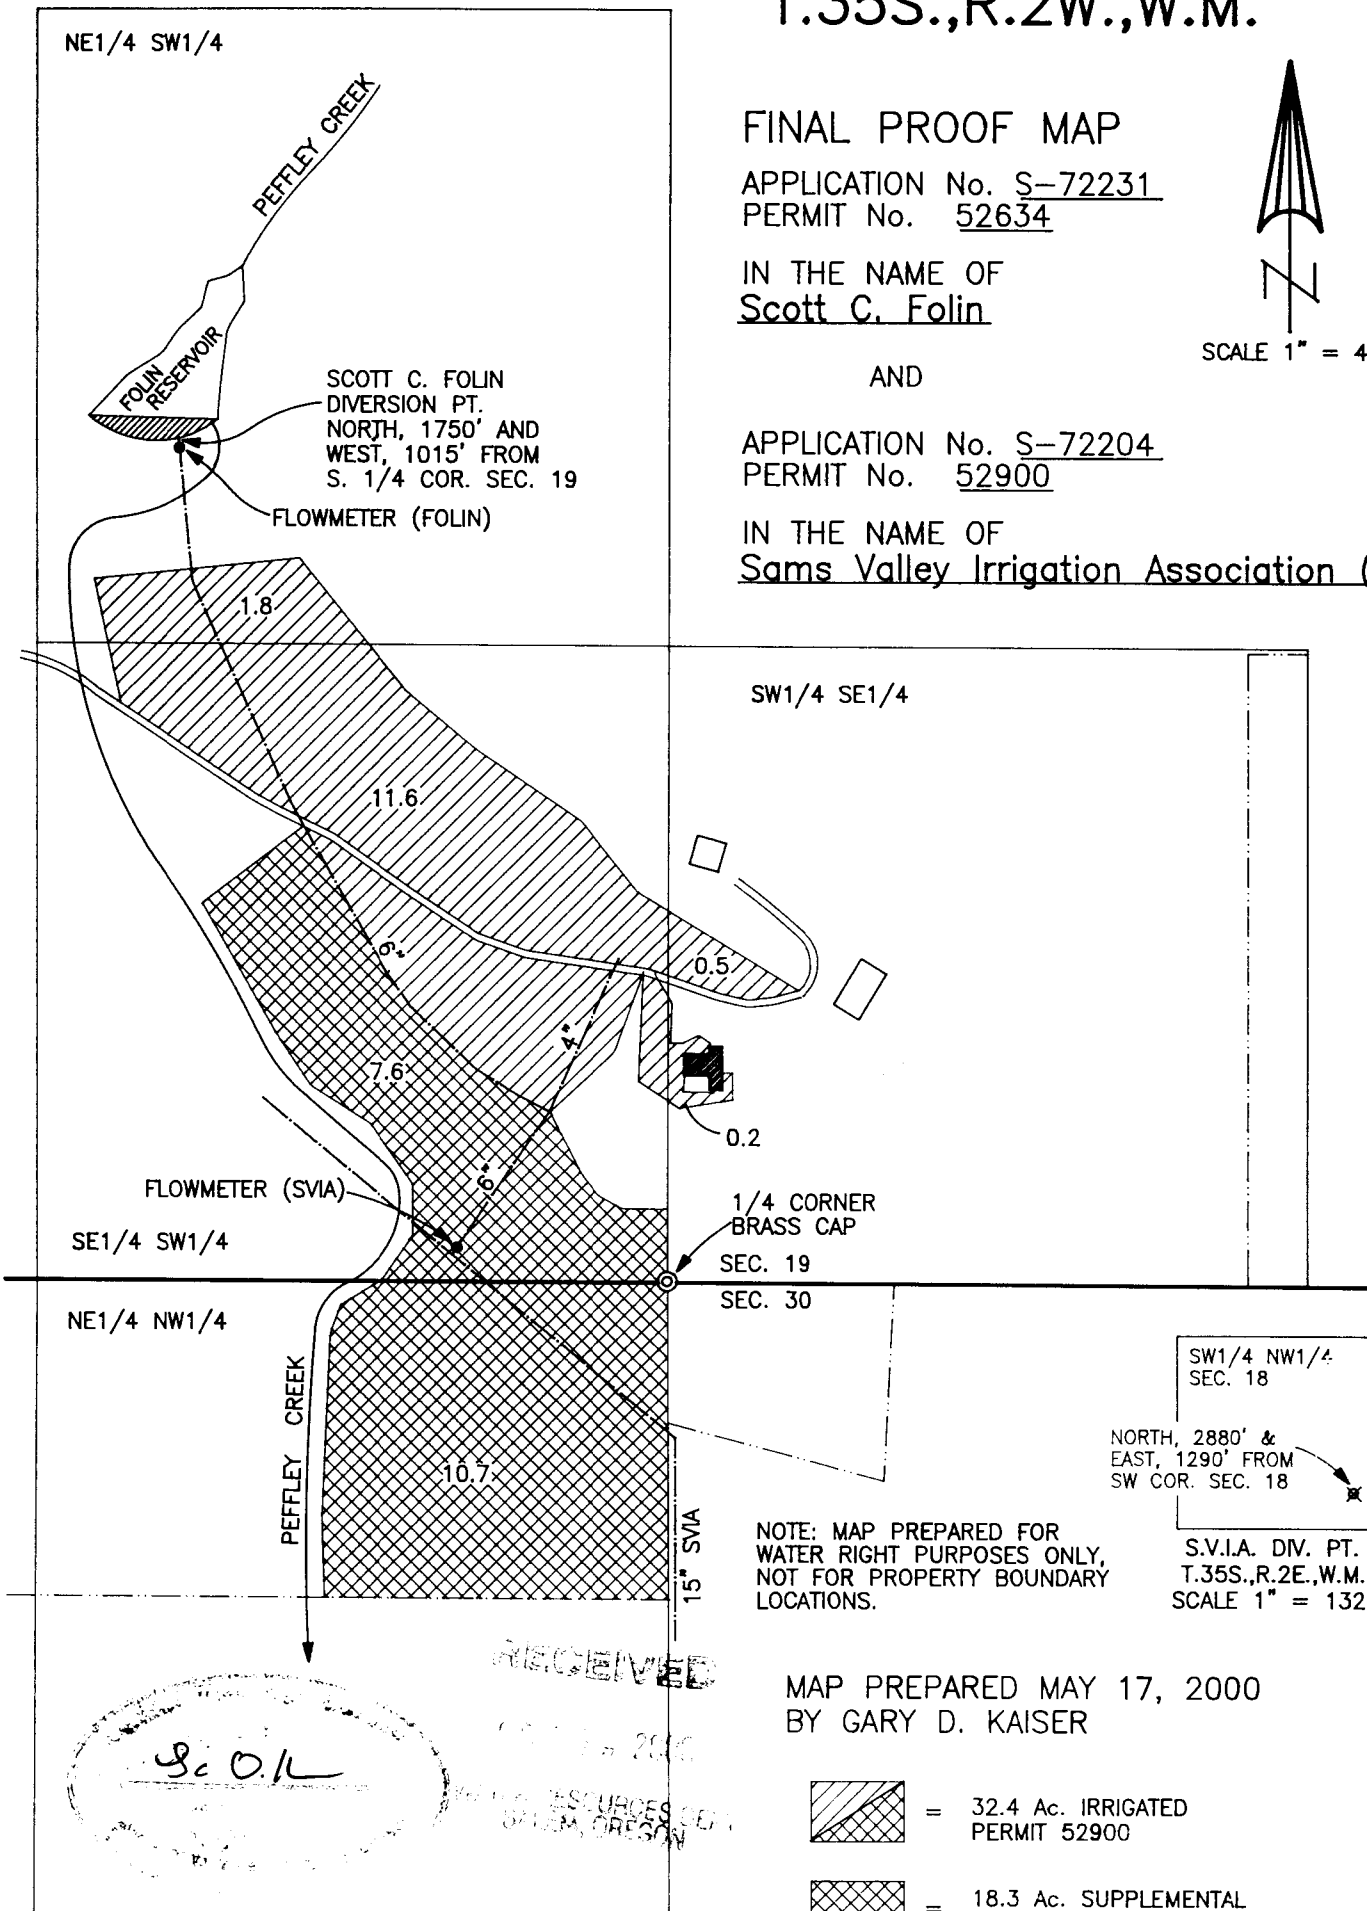

NOTE: MAP PREPARED FOR
WATER RIGHT PURPOSES ONLY,
NOT FOR PROPERTY BOUNDARY
LOCATIONS.

NORTH, 2880' &
EAST, 1290' FROM
SW COR. SEC. 18

S.V.I.A. DIV. PT.
T.35S., R.2E., W.M.
SCALE 1" = 1320'

MAP PREPARED MAY 17, 2000
BY GARY D. KAISER



= 32.4 Ac. IRRIGATED
PERMIT 52900



= 18.3 Ac. SUPPLEMENTAL
IRRIGATION PERMIT No. 52634