

CLAIM OF BENEFICIAL USE MAP

SCALE: 1 INCH = 400 FEET

DLC 39

POINT OF DIVERSION T-7263

THE INTENT OF THIS REVISED CLAIM OF BENEFICIAL USE IS THAT SUPPLEMENTAL IRRIGATION FROM THE RESERVOIR IS USED FOR THE BENEFIT OF PARCEL 2 OF PARTITION PLAT NO.

SUPPLEMENTAL IRRIGATION FROM RESERVOIR CONSTRUCTED UNDER PERMIT R-12659

PARCEL 2 OF PARTITION PLAT JOSEPHINE COUNTY, OREGON.

DLC 40

PARCEL 1 OF PARTITION PLAT JOSEPHINE COUNTY, OREGON.

CARIS CREEK IRRIGATION DITCH
C 16291


SUMP / RESERVOIR OUTLET (P.O.D.) FROM RESERVOIR LOCATED 300 FEET NORTH & 52 FEET EAST FROM THE SW CORNER SECTION 30

0.8

25 30
36 31



SUPPLEMENTAL TO PERMIT G-12784

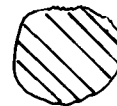

SUPPLEMENTAL TO T-7263 AND PERMIT G-12784

DLC 38

T.37 S.
R.5 W. R.4 W.
W.M.


PREPARED BY:
JONATHAN C. SPERO C.W.R.E. 123
1002 KINCAID RD./P.O. BOX 16
WILLIAMS, OREGON 97544
PH. (541) 846-6845

**UNDER:
APPLICATION S-83930 PERMIT 53578
IN NAME OF: CHERYL L. SHAW**



SURVEYED JULY 16, 1999

THIS REVISED CLAIM MAP
PREPARED
MARCH 3,
2003

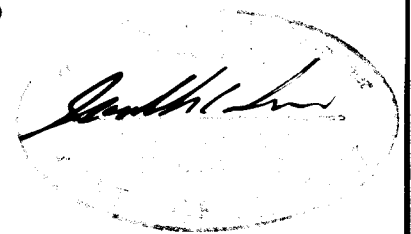

THIS MAP IS FOR THE PURPOSE OF IDENTIFYING THE LOCATION OF THE WATER RIGHT ONLY, AND IS NOT INTENDED TO PROVIDE LEGAL DIMENSIONS OR LOCATIONS OF PROPERTY OWNERSHIP LINES.

LICENSE RENEWAL DATE:
JUNE 30, 2004