
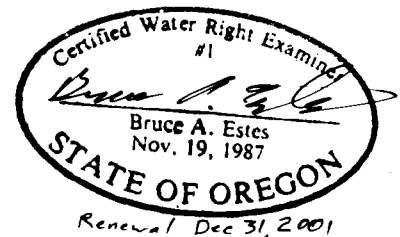


CLAIM OF BENEFICIAL USE MAP
for APPLICATION 76947, PERMIT 52615

IN THE NAMES OF: PHILIP, CHRIS & F. ANTHONY HUSERIK

T. 1 N., R. 2 W., W.M.

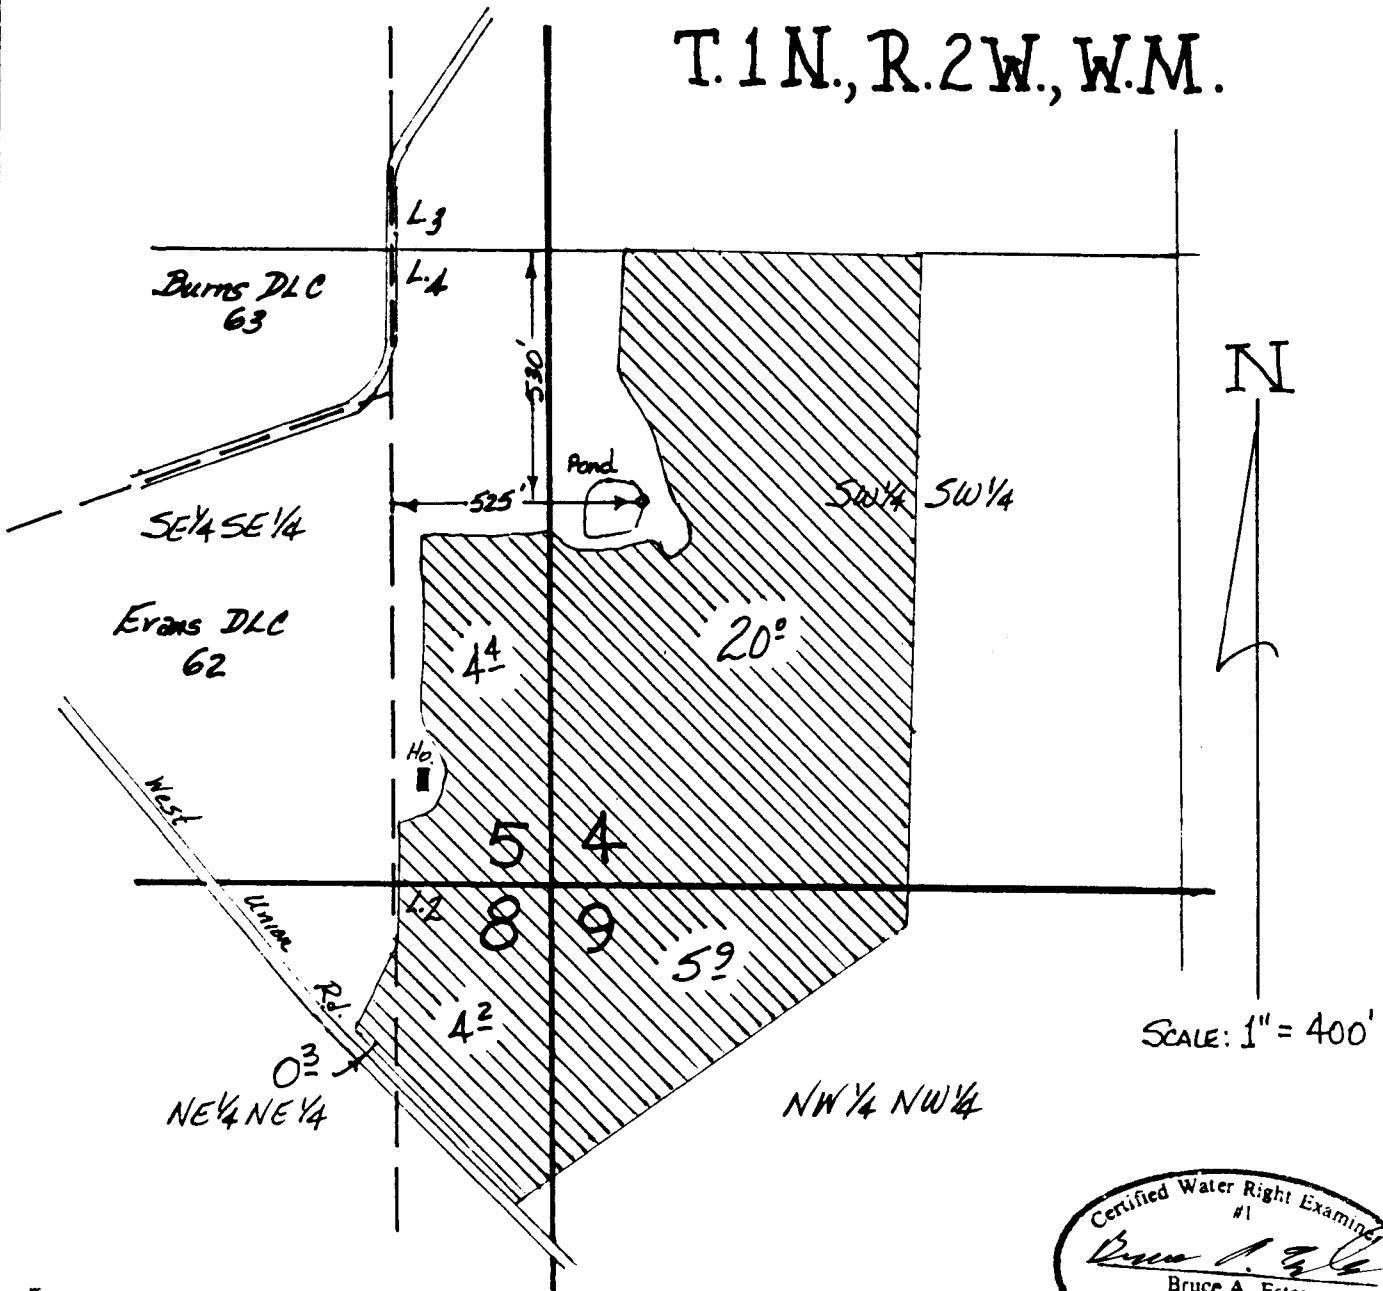

Drafted by SPA

ESTES SURVEYS

PO Box 17519
Salem, OR 97305-7519
(503) 585-7593
60382 Arnold Rd
Bend, OR 97702
(541) 382-7391

This map is for the purpose of
locating a water right only
and has no intent to provide
legal dimensions or the location
of property lines.