



AREA INCLUDES A PORTION OF  
T 17 S, R 1 W, W.M.

THE PURPOSE OF THIS MAP IS TO IDENTIFY THE LOCATION OF THE WATER RIGHTS. IT IS NOT INTENDED TO PROVIDE INFORMATION RELATIVE TO THE LOCATION OF PROPERTY OWNERSHIP BOUNDARY LINES.

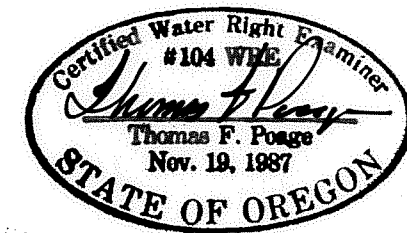

SCALE: 1" = 1320'

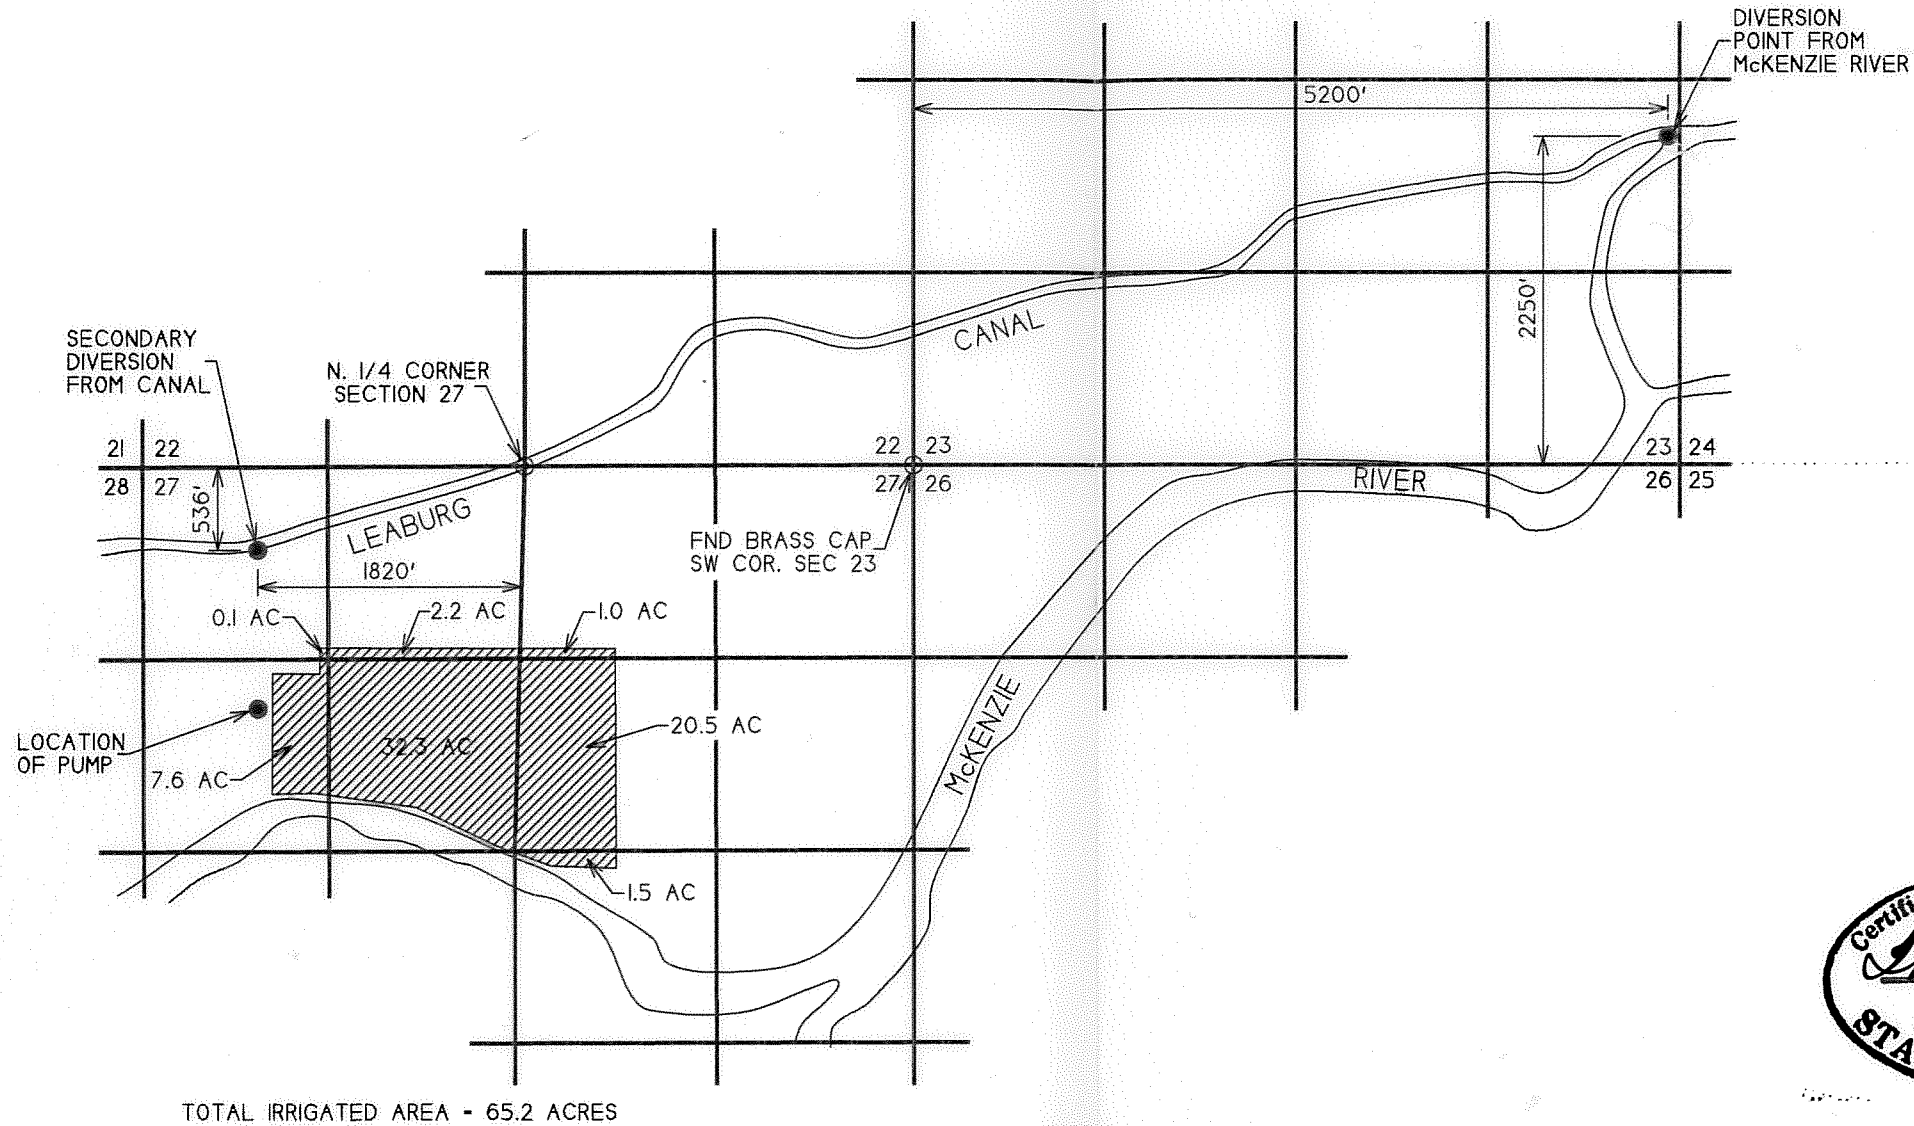

**RECEIVED**

SEP 21 2000

WATER RESOURCES DEPT.  
SALEM, OREGON

**RECEIVED**

SEP 12 2000

WATER RESOURCES DEPT.  
SALEM, OREGON

FINAL PROOF SURVEY

UNDER

APPLICATION S-71586 PERMIT 52262

IN NAME OF

**N E KNECHT**

CADD FILE: 3114PROF.GCD