

TOWNSHIP 18 SOUTH, RANGE 1 WEST, W.M.

RECEIVED

SEP 23 1999

WATER RESOURCES DEPT.
SALEM, OREGON


SW 1/4
SW 1/4

SE 1/4
SW 1/4

SCALE
1" = 400'

30 29
31 32

29
32

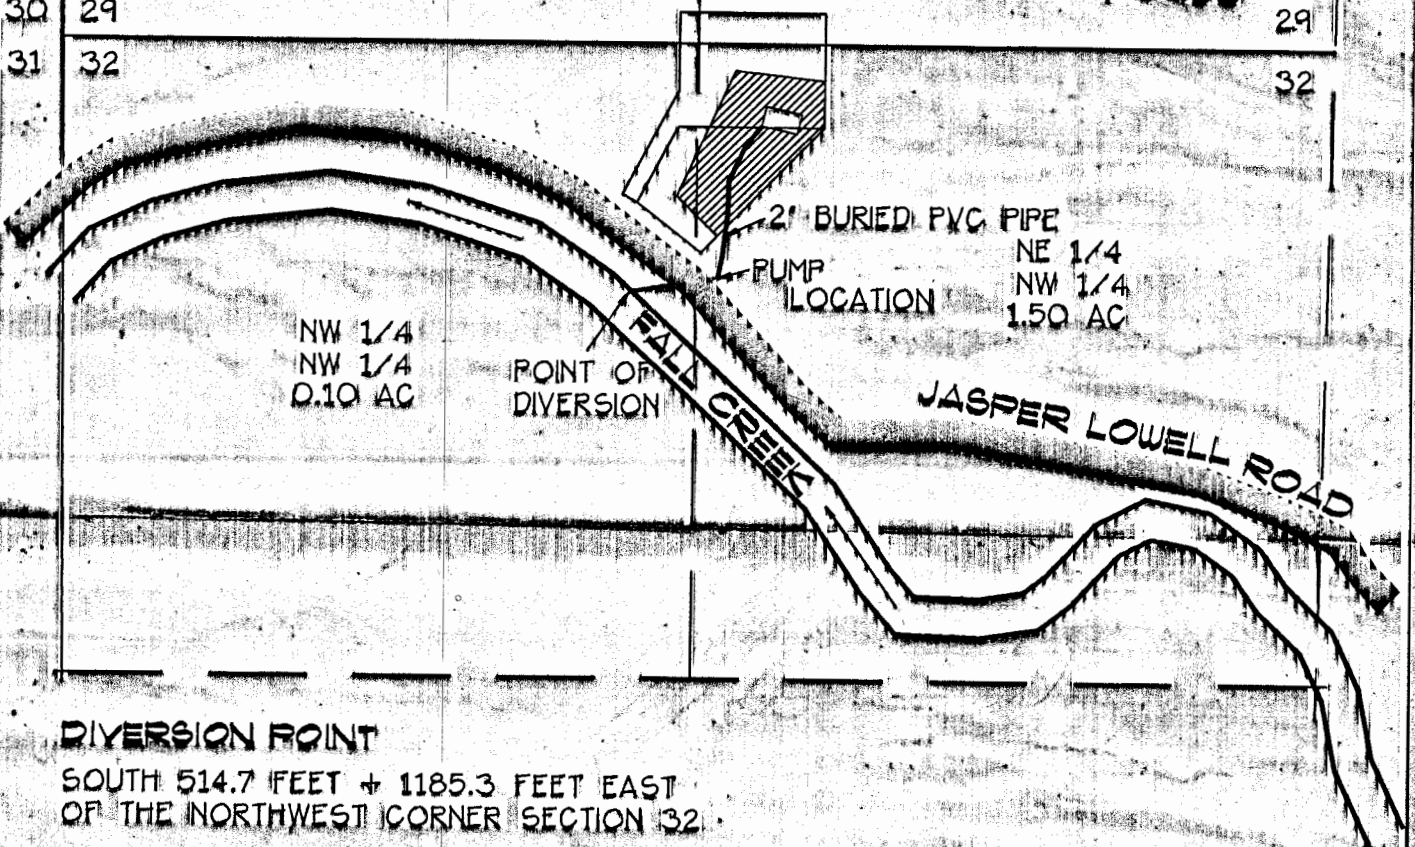


DIVERSION POINT

SOUTH 514.7 FEET + 1185.3 FEET EAST
OF THE NORTHWEST CORNER SECTION 32.



DENOTES AREA OF BENEFICIAL USE

THIS MAP WAS PREPARED FOR THE
PURPOSE OF IDENTIFYING THE LOCATION
OF THE WATER RIGHT ONLY. IT IS NOT
INTENDED TO PROVIDE DIMENSIONS OR
LOCATION OF PROPERTY OWNERSHIP LINES.
APPLICATION 6-71912 PERMIT 52816

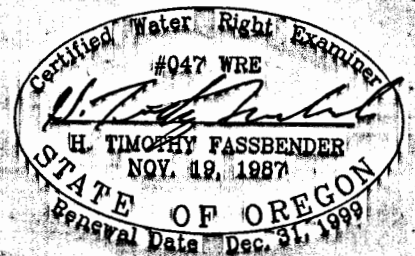

FORD-NESS-FASSBENDER

LAND SURVEYING
CONSTRUCTION SUPERVISION * WATER RIGHTS EXAMINATIONS

116 HIGHWAY 99 NORTH
Eugene, OR 97402

P.O. Box 22735
Eugene, OR 97402

(541) 344-1852
Fax (541) 344-9923

FINAL PROOF SURVEY

FOR

MARJORIE FOX

38421 JASPER LOWELL ROAD

FALL CREEK, OR 97438

PH (541) 746-1776

SEPTEMBER 15, 1999

71912