


RECEIVED

SEP 22 1999

WATER RESOURCES DEPT.
SALEM, OREGON

T14S, R5W, W.M.

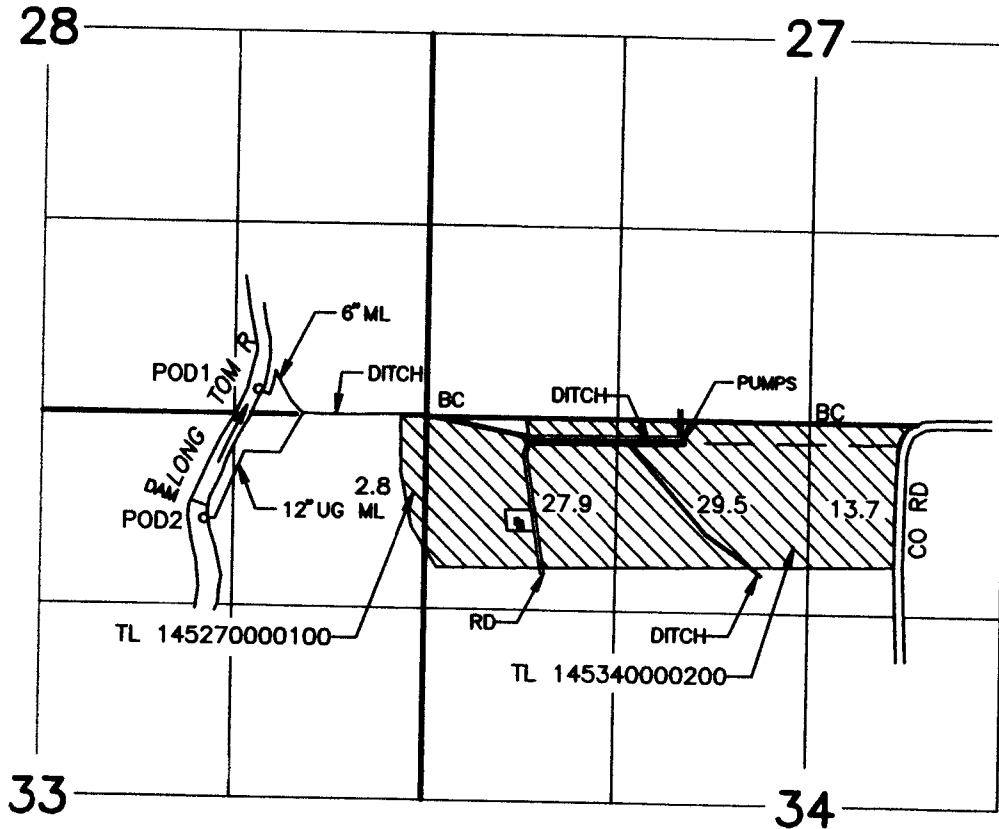

1" = 1320'

TOTAL IRRIGATION: 73.9 ACRES

POD 1, NORTH 160 FT & WEST 1140 FT FROM SW CORNER SEC 27
POD 2, SOUTH 720 FT & WEST 1490 FT FROM SW CORNER SEC 27

CLAIM OF BENEFICIAL USE MAP


IN THE NAME OF

HUBBARD FARMS INC

APPLICATION S-72146

PERMIT 52529

Prepared September 15, 1999
PARSONS SURVEYING
1915 S.E. Stone St.
Corvallis, OR 97333
(503) 752-7515
Project No. 9925

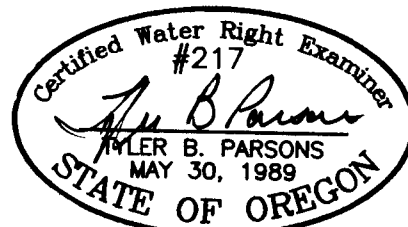

EXP: 12/31/2000

This map is for location of Water Right Application only and does not constitute a boundary survey.