


RECEIVED

200 0 0000
WATER RES. DIV.
OREGON

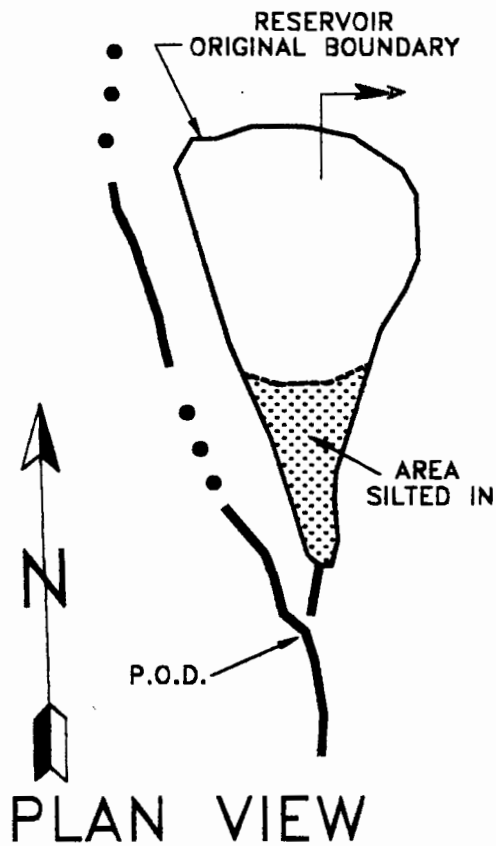


FINAL PROOF SURVEY

UNDER

Application No. R-71642 Permit R-12035

IN NAME OF

JERRY M. & PATRICIA DOUGHERTY

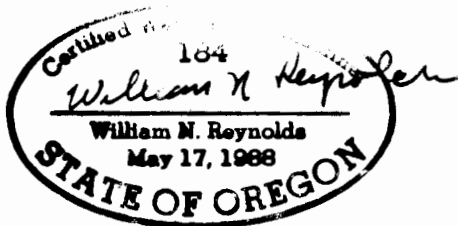

The preparation of this map is for the purpose of identifying the location of water right only, and has no intent to provide dimensions or locations of property ownership lines.

