

RECEIVED


DEC 03 1999

WATER RESOURCES DIV.
SALEM, OREGON

T.1 S., R.27 E., W.M.



SCALE 1" = 660'

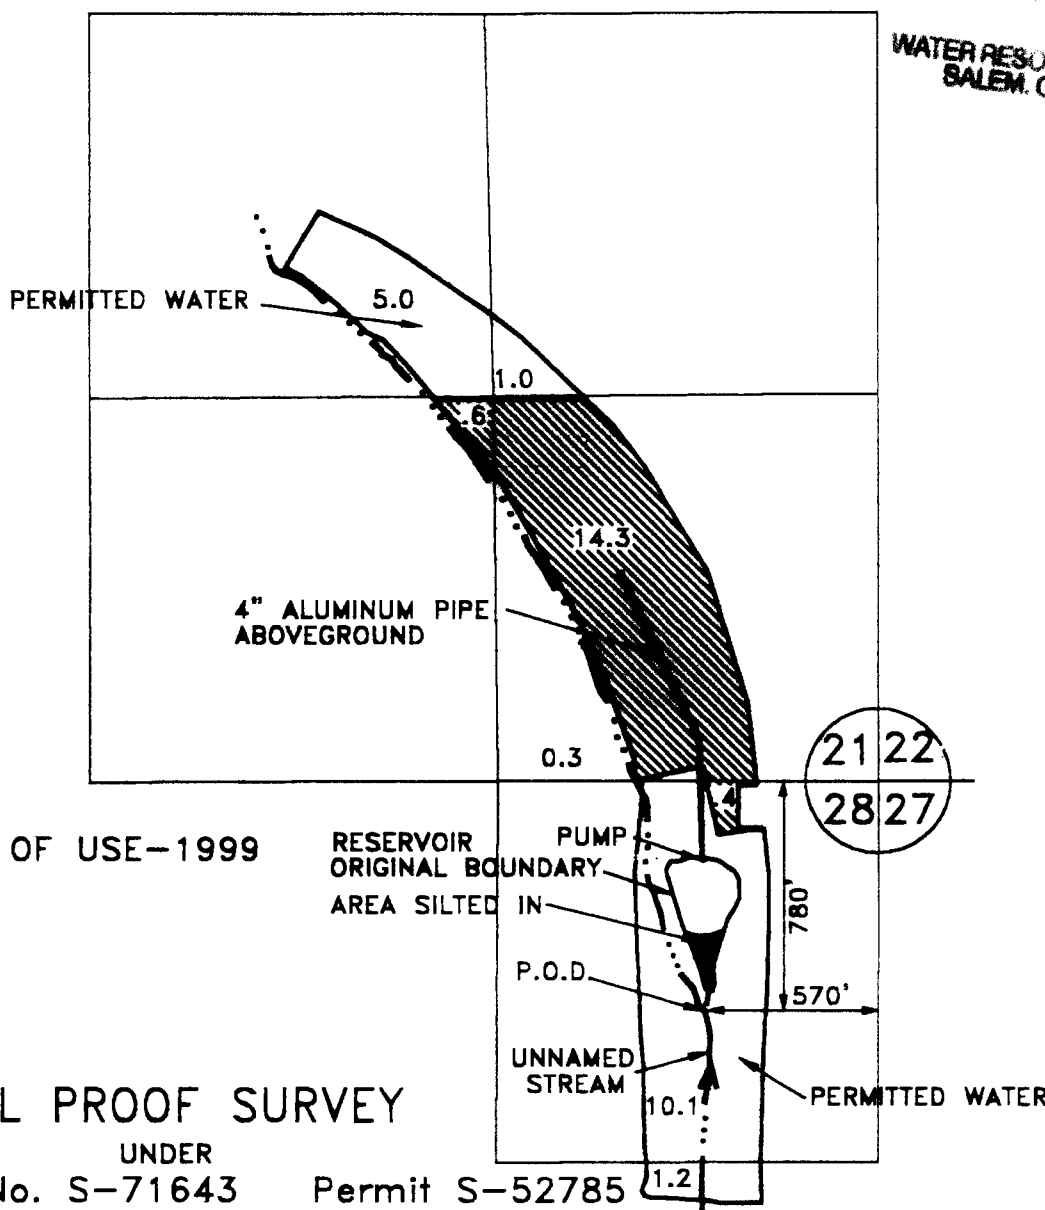

FINAL PROOF SURVEY

UNDER

Application No. S-71643

Permit S-52785

Application No. R-71642

Permit R-12035

IN NAME OF

JERRY M. & PATRICIA DOUGHERTY

The preparation of this map is for the purpose of identifying the location of water right only, and has no intent to provide dimensions or locations of property ownership lines.

