

T.35 S. R.07 W. W.M.

FINAL PROOF SURVEY

APPLICATION S-80623 PERMIT 52632

IN NAME OF:

PICKETT CREEK IRRIGATION ASSOCIATION, INC.

RECEIVED

SEP 27 1999

WATER RESOURCES DEPT.
SALEM, OREGON



PRIMARY PER THIS PERMIT (No. 52632)



SUPPLEMENTAL TO: C-44724 / T-7413




SUPPLEMENTAL TO: C-16593 / T-7413



SUPPLEMENTAL TO: T-7413

S = SUMP

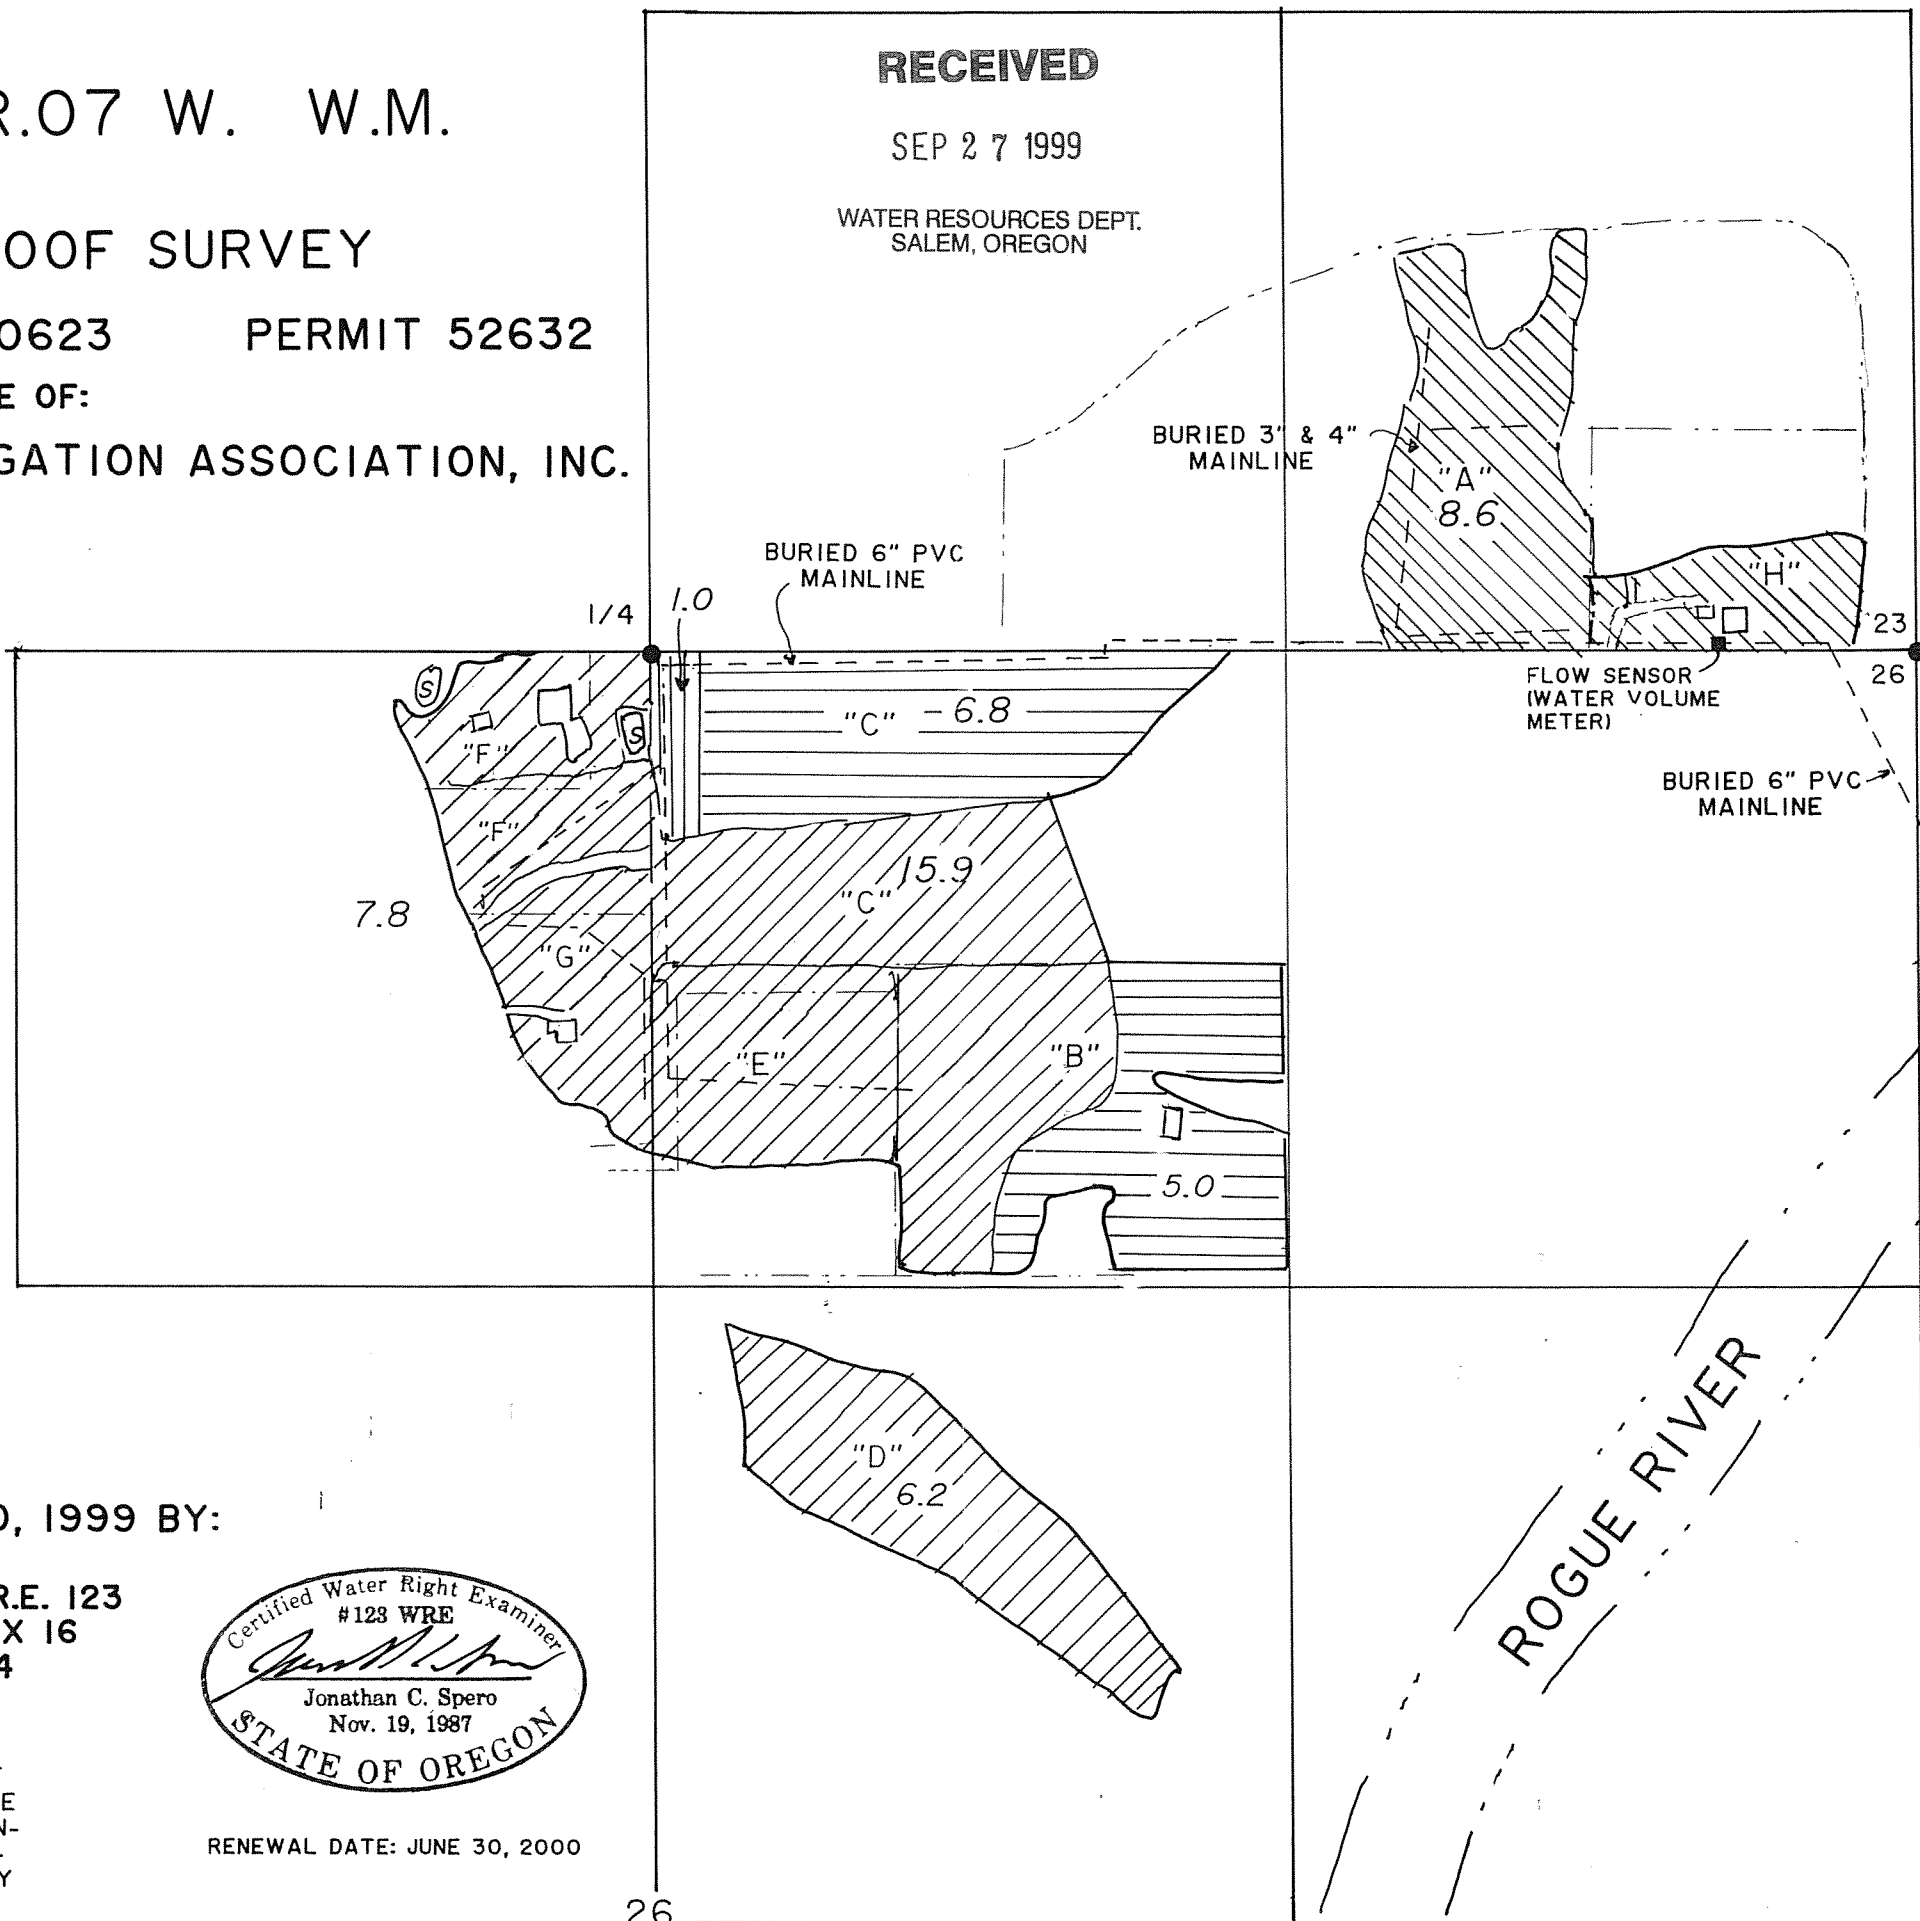


DIVERSION POINT FROM ROGUE RIVER
650' SOUTH & 150' EAST
FROM NE COR. SEC. 26

SOURCE OF WATER:
LOST CREEK RESERVOIR
UNDER PERMIT R-8142
A TRIBUTARY OF THE
ROGUE RIVER

ROGUE RIVER

SURVEYED AUGUST 30, 1999 BY:

JONATHAN C. SPERO C.W.R.E. 123
1002 KINCAID RD./P.O. BOX 16
WILLIAMS, OREGON 97544
PH. (541) 846-6845

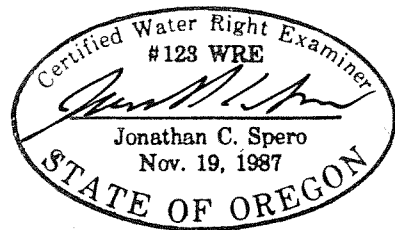

RENEWAL DATE: JUNE 30, 2000

THIS MAP IS FOR THE PURPOSE OF IDENTIFYING THE LOCATION OF THE WATER RIGHT ONLY, AND IS NOT INTENDED TO PROVIDE LEGAL DIMENSIONS OR LOCATIONS OF PROPERTY OWNERSHIP LINES.

SCALE: 1" = 400'