


Claim of Beneficial Use Map

Permit G-15821, Application G-16124
Water Right in the Name of City of Dayton

Township 4 South, Range 3 West, Section 19, as projected within DLC 48 (W.M.)

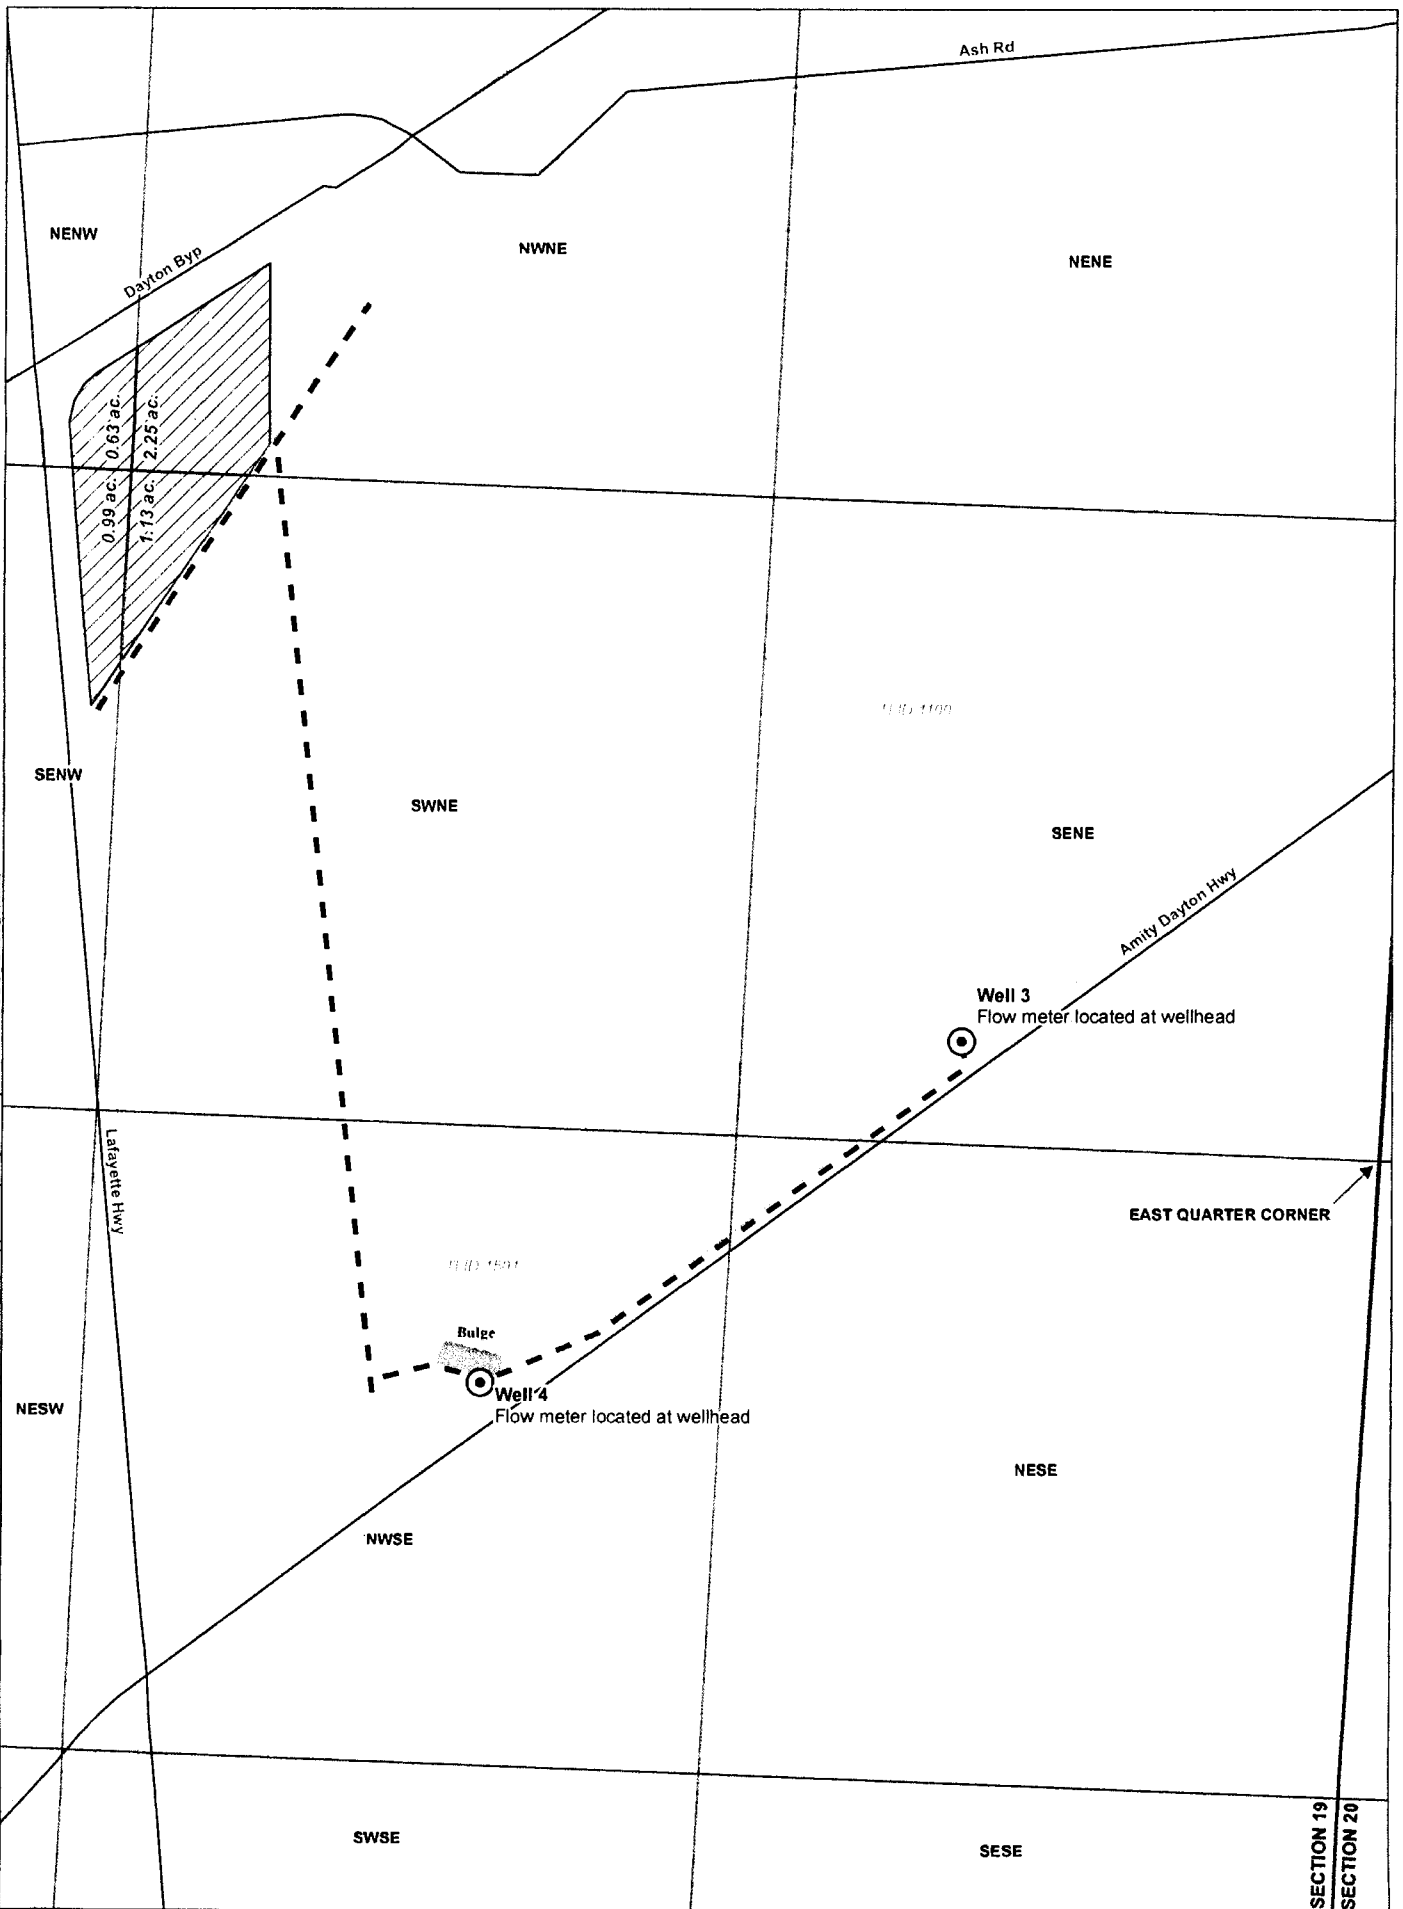

COBU 855

Document Path: P:\Portland\107 - Dayton\019 - Dayton (aka Fisher) Nursery Water Rights Support\Project_GIS\Project_mxd\COBU_G15821.mxd

LEGEND

- Point of Appropriation (POA)
- Place of Use (POU)
- Mainline
- Street
- Tax Lot
- Waterbody

POA Location Description


Well 3 (YAMH 52469)

Located 220 feet North and 880 feet West from the East quarter corner of Section 19, Township 4 South, Range 3 West (W.M.)

Well 4 (YAMH 5447)

Located 545 feet South and 1,840 feet West from the East quarter corner of Section 19, Township 4 South, Range 3 West (W.M.)

Certified Water Rights Examiner Stamp

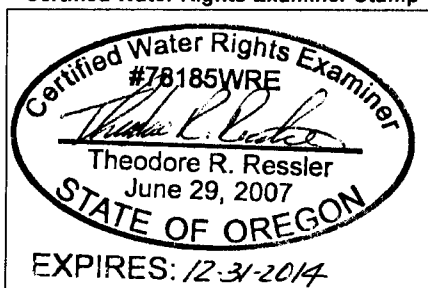

Disclaimer

This map was prepared for the purpose of identifying the location of a water right only and it is not intended to provide legal dimensions or location of property ownership lines

Map Notes

Date: October 22, 2014
Data Sources: BLM, USGS, ESRI
Prepared By: GSI Water Solutions, Inc.

