


857

# Claim of Beneficial Use Map

Permit G-17039, Application G-15130  
Water Right in the Name of City of Dayton

Township 4 South, Range 3 West, Section 19, as projected within DLC 48 (W.M.)

COBU map # 857

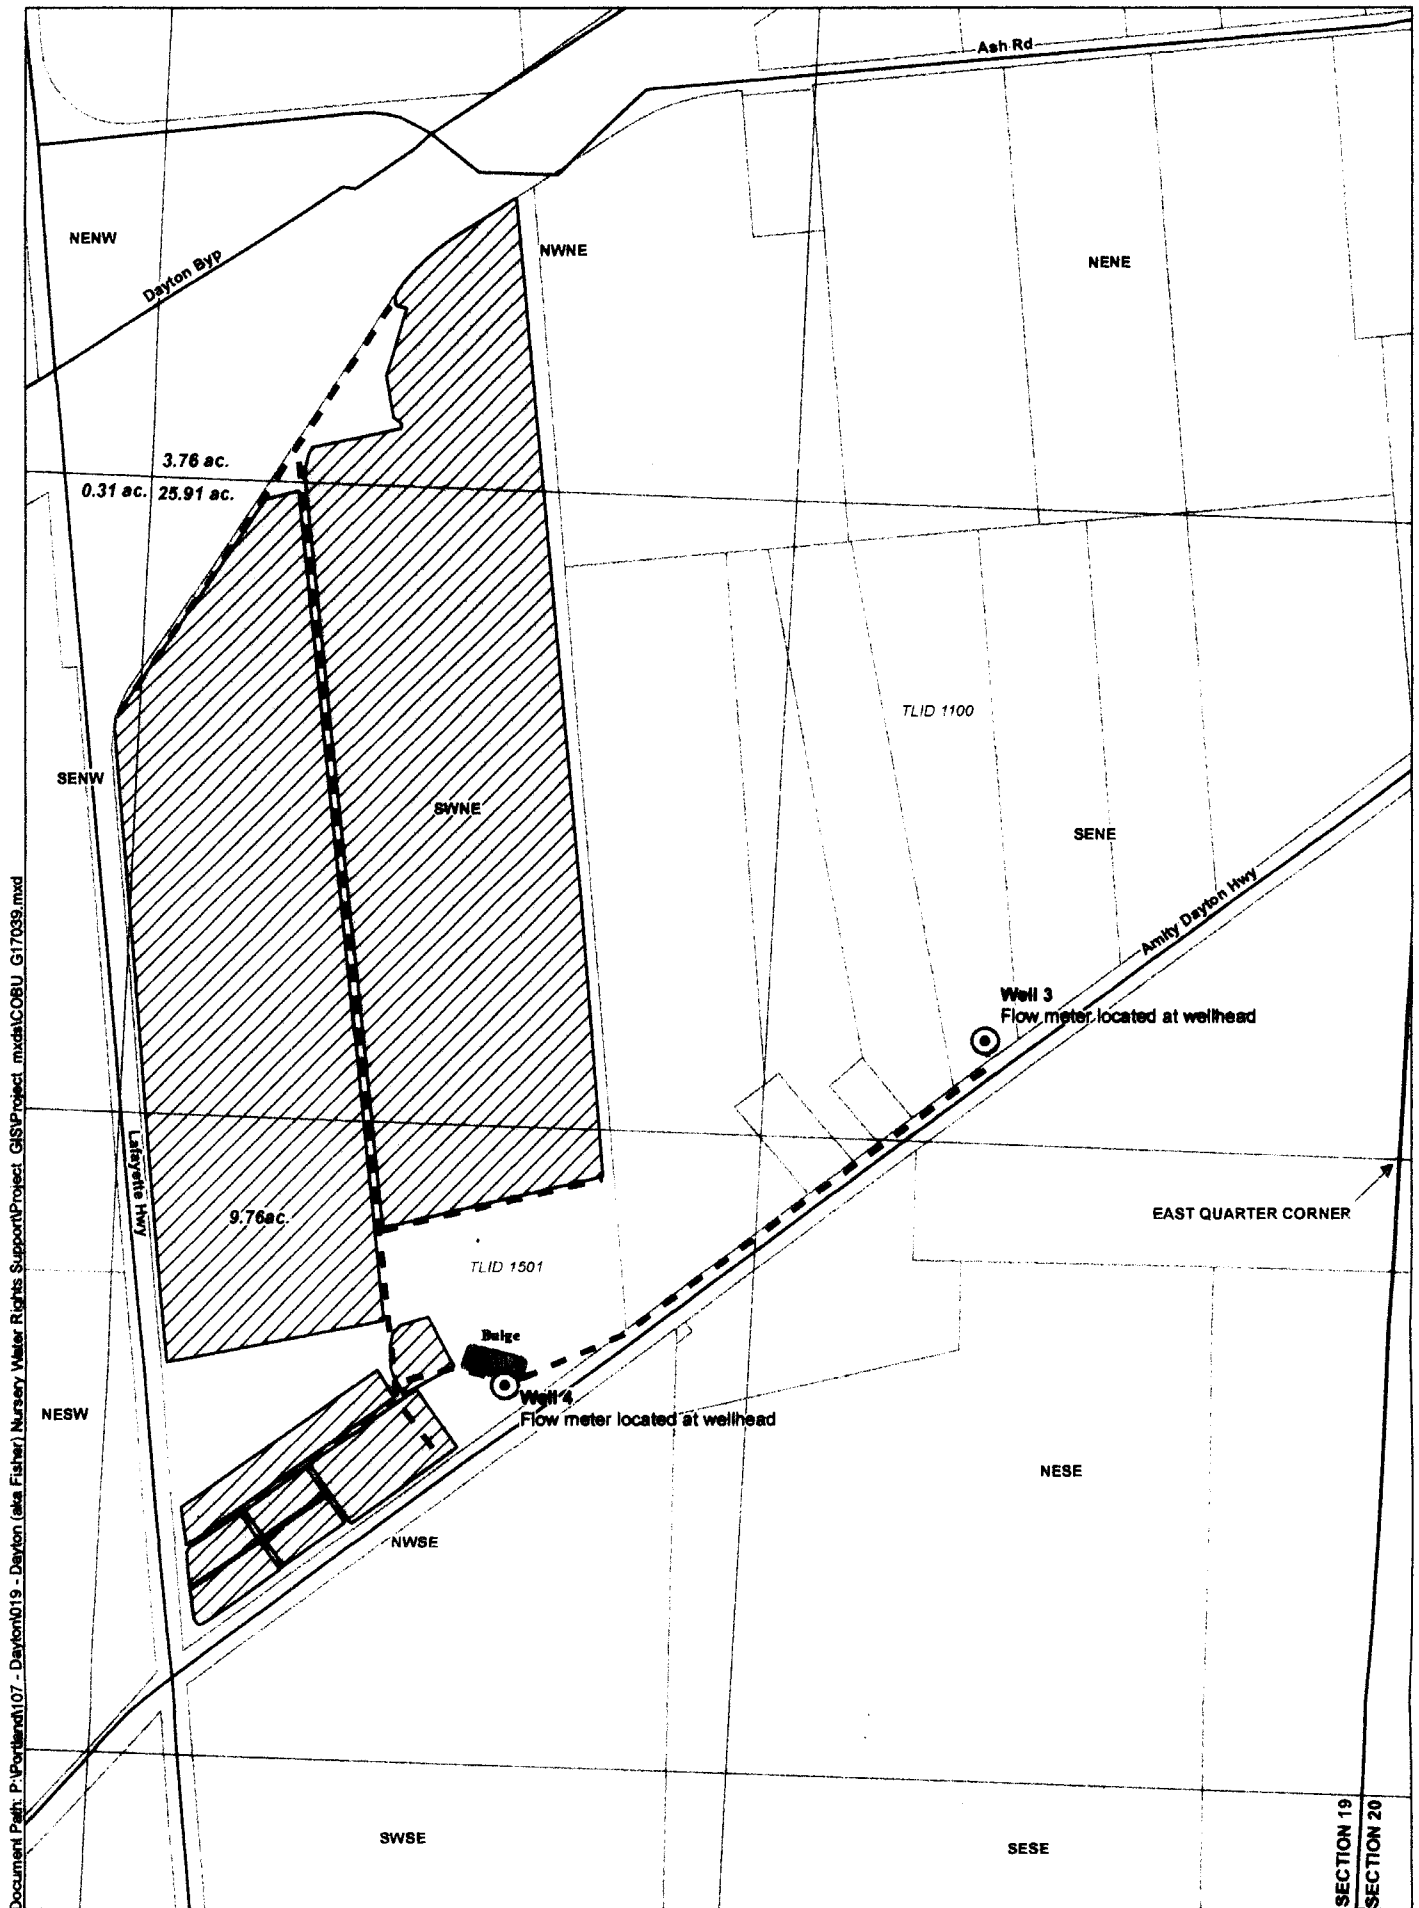


Document Path: P:\Portland\107 - Dayton\019 - Dayton (aka Fisher) Nursery Water Rights Support\Project\_GIS\Project\_mxd\COBU\_G17039.mxd

- LEGEND**
- Point of Appropriation (POA)
  - Place of Use (POU)
  - Mainline
  - Street
  - Tax Lot
  - Waterbody

**POA Location Description**

**Well 3 (YAMH 82488)**  
Located 220 feet North and 880 feet West from the East quarter corner of Section 19, Township 4 South, Range 3 West (W.M.)

**Well 4 (YAMH 8447)**  
Located 545 feet South and 1,840 feet West from the East quarter corner of Section 19, Township 4 South, Range 3 West (W.M.)

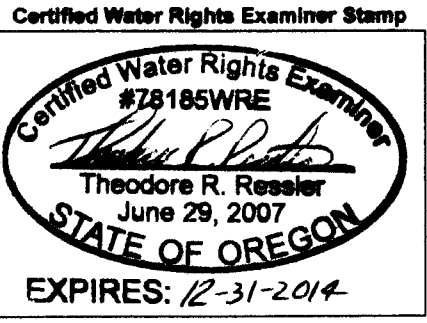

**Disclaimer**  
This map was prepared for the purpose of identifying the location of a water right only and it is not intended to provide legal dimensions or location of property ownership lines.

**Map Notes**  
Date: September 11, 2014  
Data Sources: BLM, USGS, ESRI  
Prepared By: GSI Water Solutions, Inc.

