

8437

8944


8945

- Map -

Accompanying application of W.A. Cox of Finchurst,  
Jackson County, Oregon. for permit to the waters of a  
Spring tributary to Keen Creek. Jackson County, Oreg.  
for Domestic purposes

April 1928

Tp. 40S. R.4E. WM.

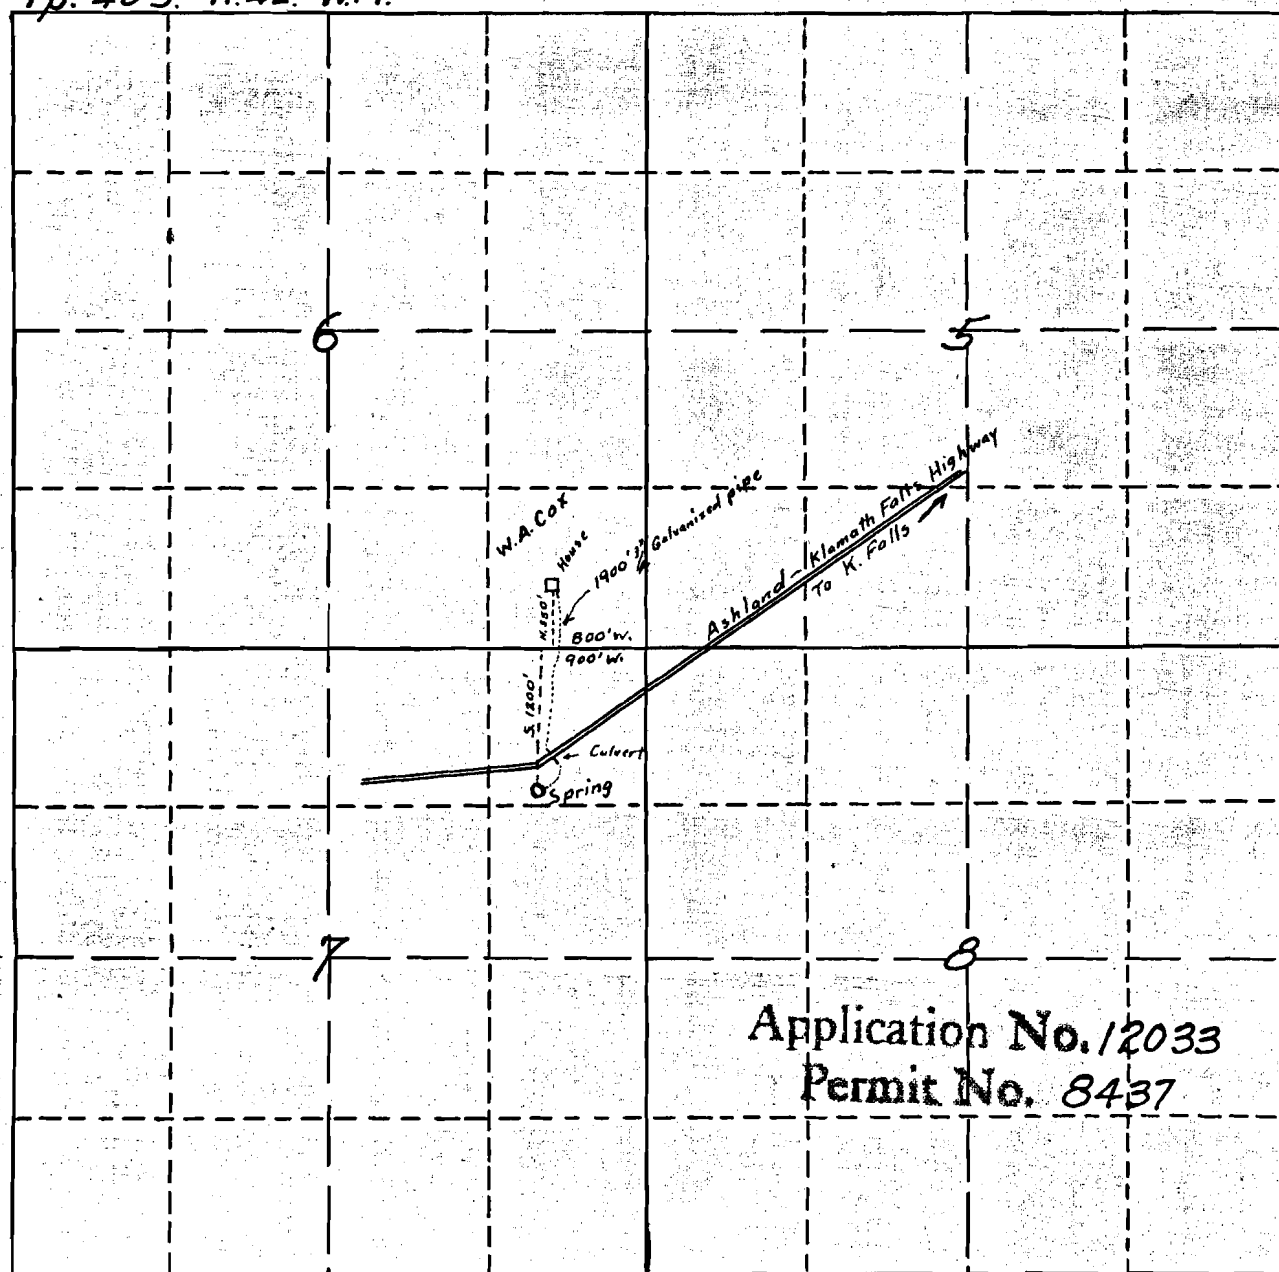

Application No. 12033  
Permit No. 8437

Map made from measurements taken in the field by  
Wilbur M. Darby correctly showing location of spring,  
place of use together with the Ashland-Klamath Falls  
Highway in the immediate vicinity. Compiled by Wilbur M. Darby  
Asst. Water Master

Keen Cr. Misc