


FINAL PROOF SURVEY


T 4 S R 5 W WM.

SW ¼ of SECTION 26

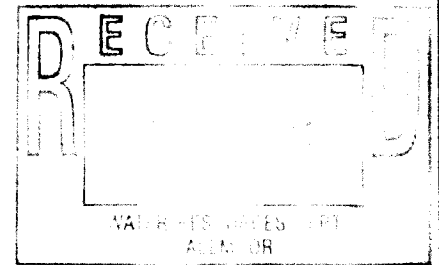


application # R-81396 permit # R-12143

For: Bible Mennonite Church Inc.

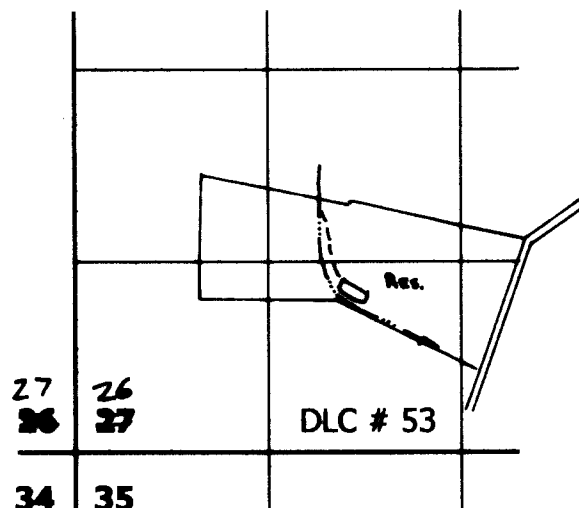

reservoir location: N 60 E, 2175' from the SW corner section ~~27~~26

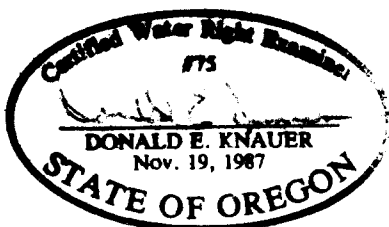

Scale 1" = 1320'

This map is to be used for water right purposes only.

Don Knauer Consulting
PO Box 5416
Salem, OR 97304
503-585-8474

Map Updated By WRD NC 2/6/2015