


FINAL PROOF MAP  
 T.40S. R.18E., W.M.  
 SECTION 24  
 TAX LOT 2201  
 EVANS RESERVOIR  
 APPLICATION R-74403 PERMIT R-11860

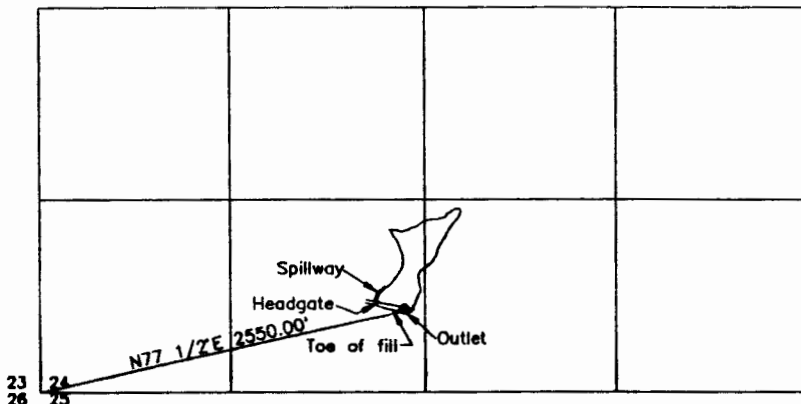


**RECEIVED**

**SEP 21 2000**

**WATER RESOURCES DEPT.  
 SALEM, OREGON**

PREPARED FOR: BOBBY & BILLIE EVANS  
 PREPARED BY: SUNDET & ASSOCIATES  
 P.O. BOX 1228  
 LAKEVIEW, OR 97630  
 (541)947-3293  
 AUGUST 2000 DRAWING #12100A

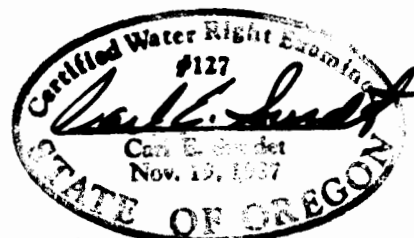

**RENEWS 6/30/02**

This map is for the purpose of identifying the location of the water right only and is not intended to provide legal dimensions or property ownership lines.