


T.6S.,R.6W.,W.M.

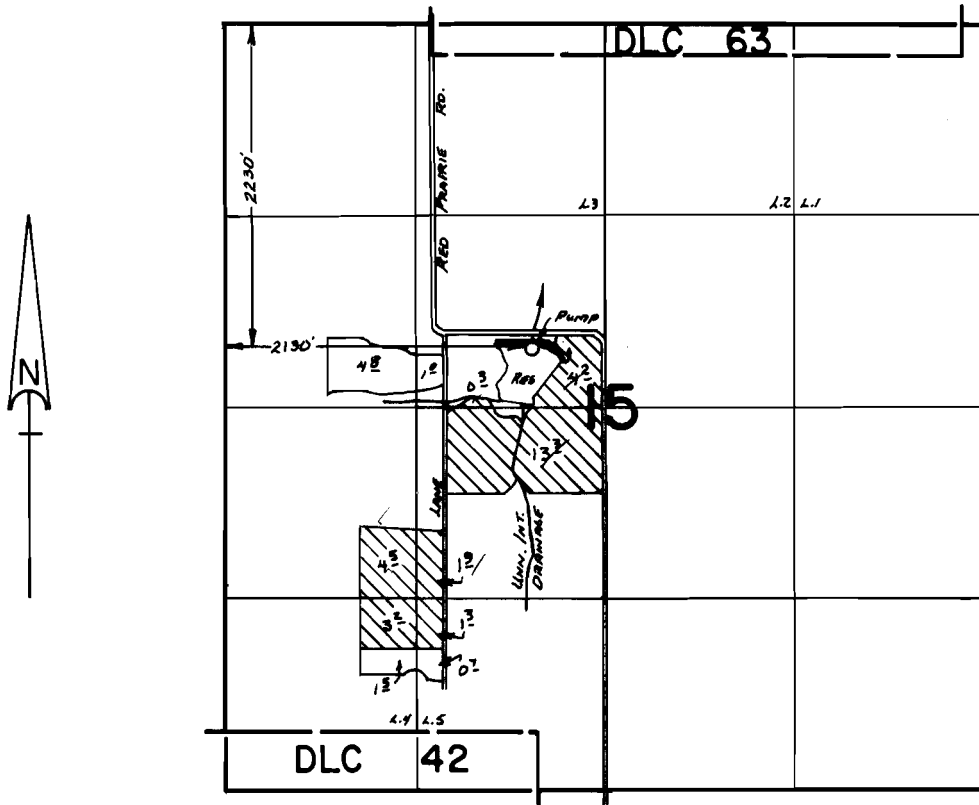

SCALE: 1" = 1320'

FINAL PROOF SURVEY UNDER

Application No. R-53577 53578... Permit No. R-6397 39938.....
IN NAME OF

.....BUDD & JILL SHAFFER.....

Surveyed Aug...4... 19.83., by ..L..M..TOLL.....