

RECEIVED

OCT 0 1 2000



WATER RESOURCES DIV.
BUREAU OF LAND MANAGEMENT

CLAIM OF BENEFICIAL USE MAP

UNDER APPLICATION R-81933 ; PERMIT R-12308

NW1/4 SE 1/4 SEC 8 T 32S R 46E W.M.


U.S.G.S. QUAD - PARSINP PEAK, OREG. - 7 1/2'

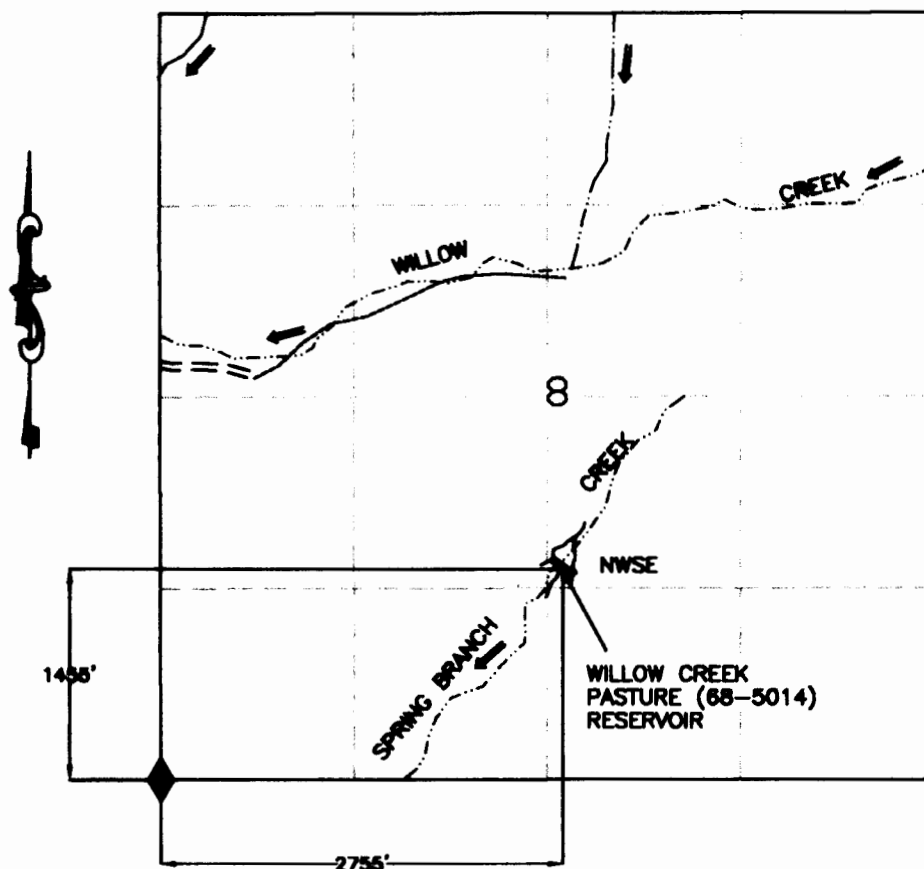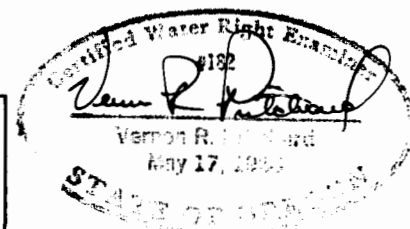

LEGEND

- RESERVOIR
- ROAD
- TRAIL
- CHANNEL
- FD SEC COR

WILLOW CREEK PASTURE (68-5014) RESERVOIR

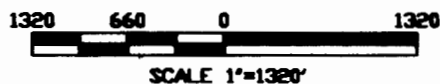

I, [Signature] Acting ADM Operations/Field Services agree to the findings of the CWRE and do submit this site report and map as my Claim of Beneficial Use of the water as provided under the terms and conditions of my Permit R-12308

THIS MAP IS FOR THE PURPOSE OF LOCATING A WATER RIGHT AND IS NOT INTENDED TO PROVIDE LEGAL DIMENSIONS FOR LOCATION OF PROPERTY BOUNDARIES.



ACAD14
DWG FILEWILCRPASBEN

UNITED STATES DEPARTMENT OF THE INTERIOR	
BUREAU OF LAND MANAGEMENT	
DIVISION OF OPERATIONS	VALE DISTRICT
WILLOW CREEK PASTURE (68-5014) RESERVOIR	
DRAWN BY:	<u>[Signature]</u>
SURVEYED:	<u>[Signature]</u>
APPROVED:	<u>[Signature]</u>
DRAWN: CG	SCALE: 1"=1320'
DATE: 10/18/00	SHEET 1 OF 1
DRAWING NO. OR-03-9172.45-1064	