

8437

8994

8995


1 of 2

- Map -

Accompanying application of W.A. Cox of Pinehurst,
Jackson County, Oregon. for permit to the waters of a
Spring tributary to Keene Creek. Jackson County, Oreg.
for Domestic purposes

April 1928

Tp. 40S. R.4E. W.M.

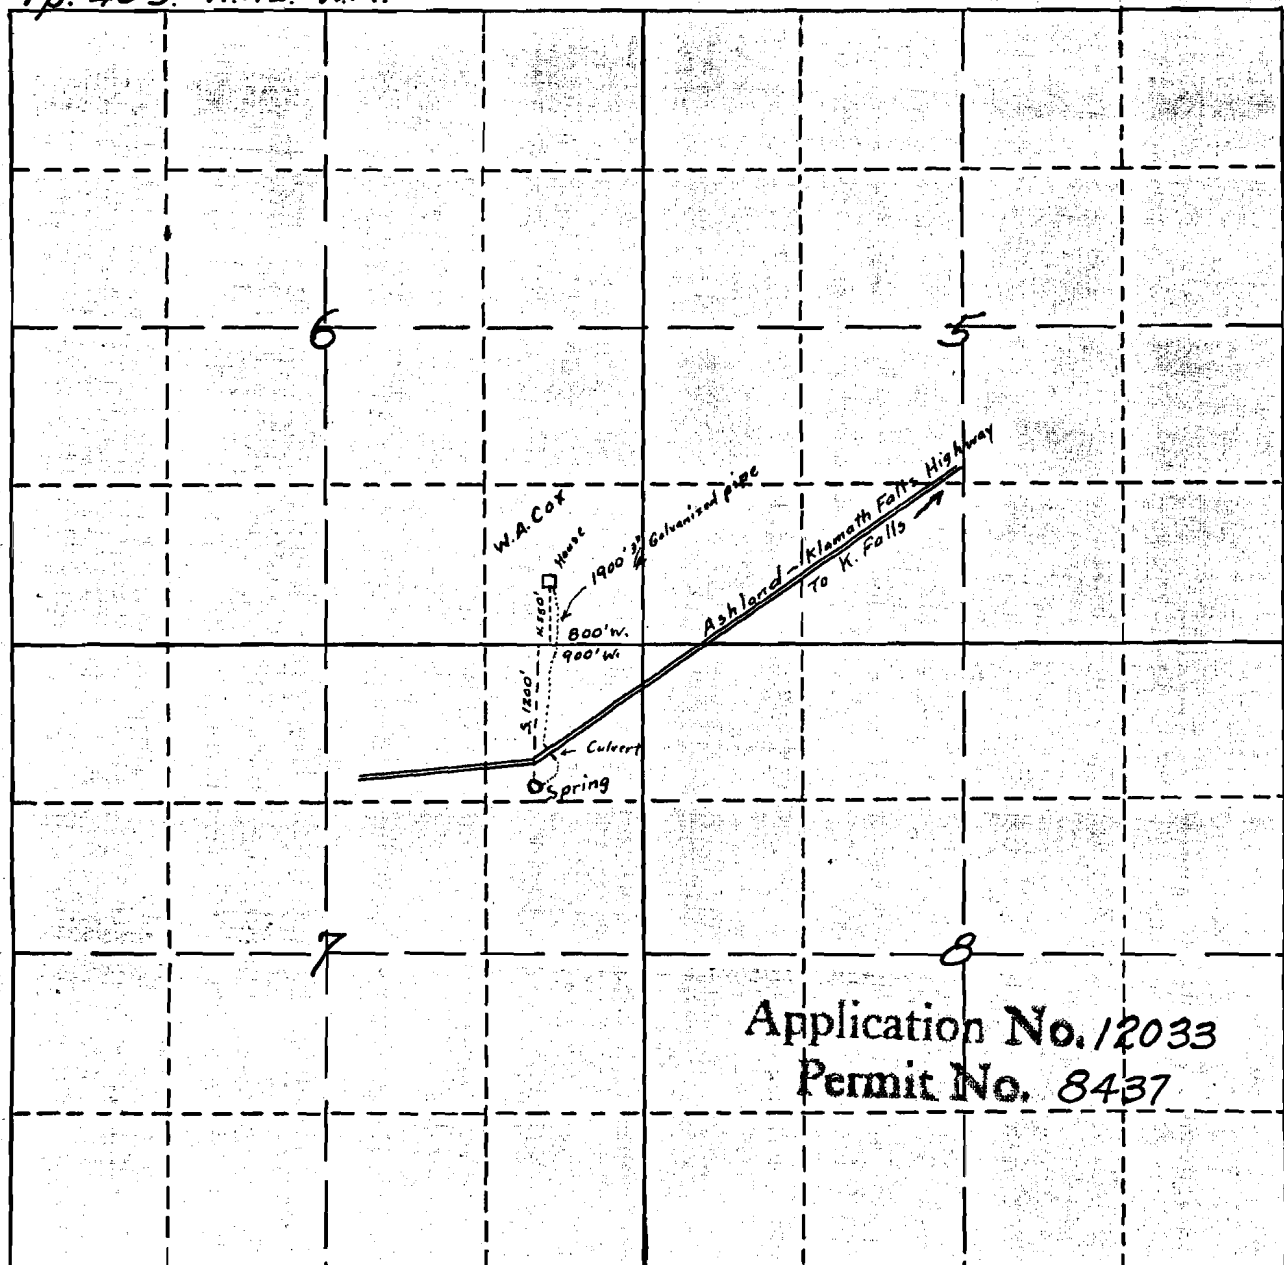


Application No. 12033
Permit No. 8437

Map made from measurements taken in the field by
Wilbur M. Darby correctly showing location of spring,
place of use together with the Ashland - Klamath Falls
Highway in the immediate vicinity. Compiled by Wilbur M. Darby
Asst. Water Master

App 12033
8437
2082

Map
Accompanying Final Proof of W.A. Cox and T.W. Kluck
of Pinehurst, Jackson County Oregon, of permit to
use of waters of unnamed Spring tributary to Keene
Creek Jackson County Oregon
App. No. 12033
Permit No 8437
Nov. 1930

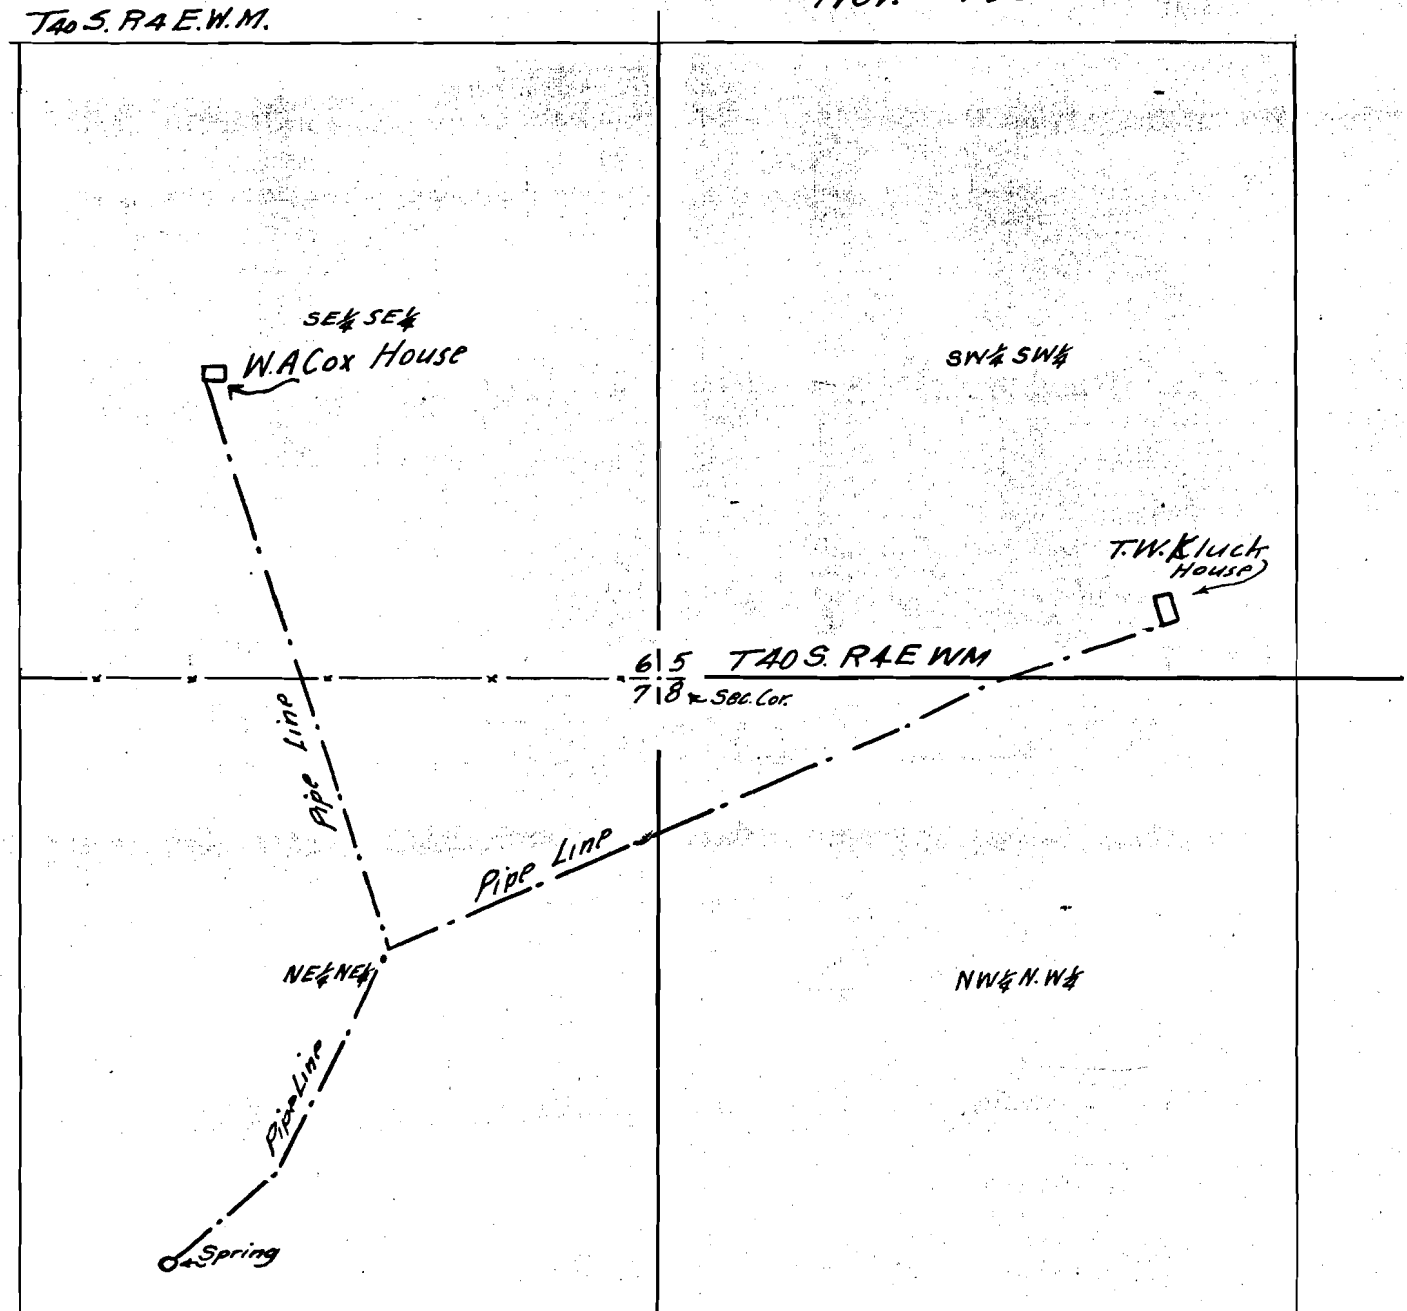

Map made from Plane Table survey made by
Chester A. Cummings

Compiled by
Chester A. Cummings
Asst. Water Master