

T29S R3W WM

RECEIVED

SEP 25 1999

WATER RIGHTS DIVISION

DANIEL T. CRAIG
DLC 37

FOUND
BRASS CAP
AT 1/4
CORNER
19/20

SECTION 19

SECTION 20

HOUSE

NW 1/4
SW 1/4

N 32° 54' W
968

DITCH

STREAM

DITCH

RES.


UNNAMED

LANE

SOUTH

MYRTLE

ROAD

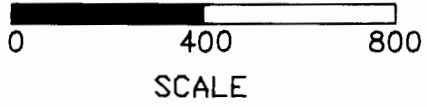

THIS MAP TO BE USED
FOR WATER RIGHT
PURPOSES ONLY.

APPLICATION # R-72050

PERMIT # R-11949

MAP FOR CLAIM OF BENEFICIAL USE
IN NAME OF *Richard M. Deam*

DATE SEPT. 7, 1999

BY: WILLIAM J. RUPPERT
P.O. BOX 1564
MYRTLE CREEK, OR 97457

