


TOWNSHIPS 5&6 NORTH, RANGE 35 EAST, W.M.

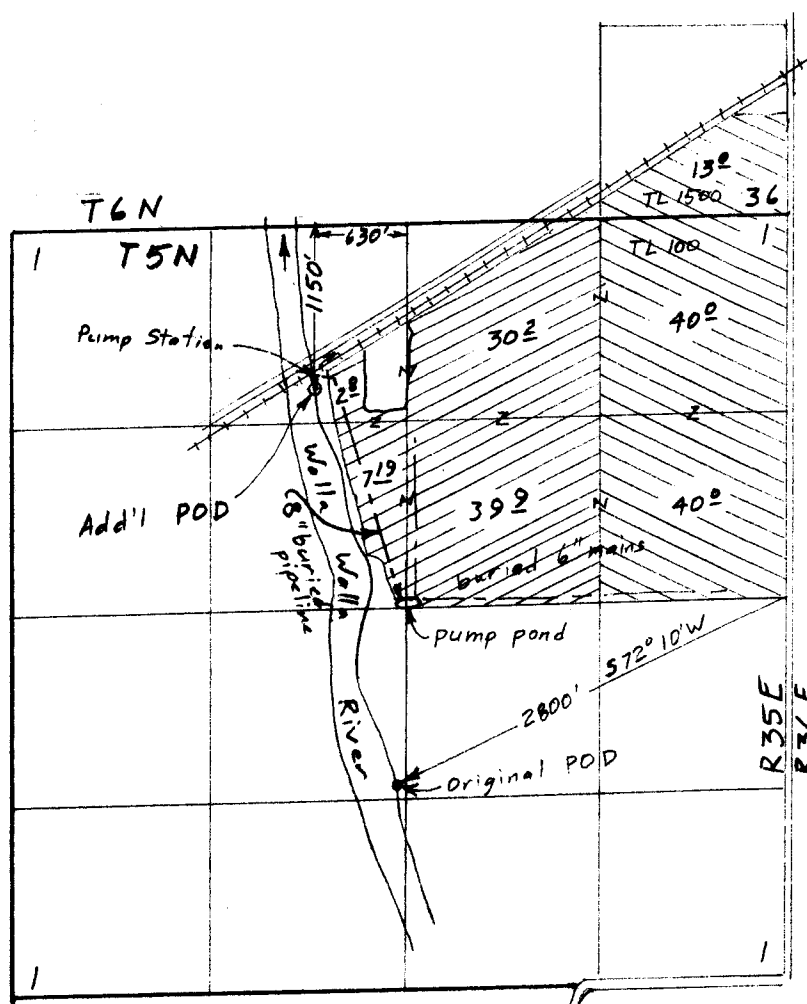

Scale 1" = 1320'


Surveyed August 30, 2003

- ⊗ 1897 (80<sup>22</sup> acres)
- ⊗ July 12, 1912 (93<sup>00</sup> acres)

Claim of Beneficial Use Map  
for

J. Frank Schmidt & Son Co.

T-9121

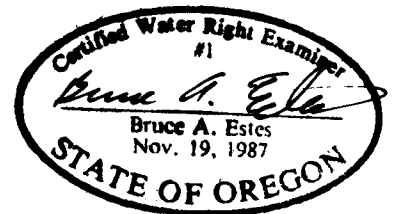

Renewal Dec 31, 2003

This map is for the purpose of locating a water right only and has no intent to provide legal dimensions or the location of property lines.

**ESTES SURVEYS, LLC**

PO Box 17519 60382 Arnold Rd  
Salem, OR 97305-7519 Bend, OR 97702  
(503) 585-7593 (541) 382-7391